


Douglas **KANSAS**

Section 20 Township 13 Range 21E

Well No. #2 McBride

Company Goff Oil & Gas

NORTH **Miscellaneous**

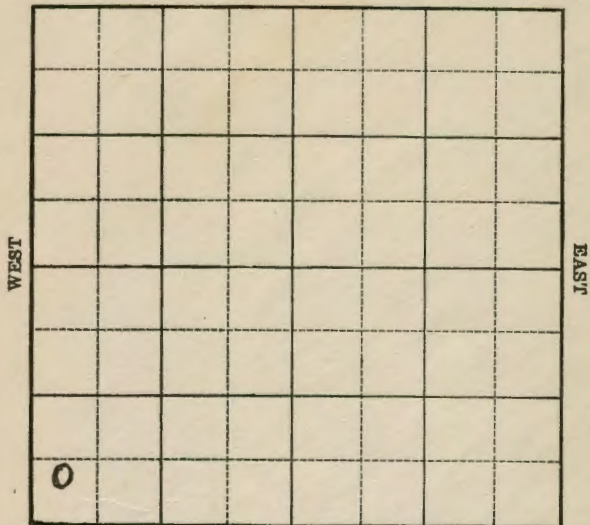

SOUTH

**KANSAS**

Douglas

Sec. 20 Twp. 13 R. 21-E

Well No. #2 McBride Farm \_\_\_\_\_

Goff Oil & Gas Company \_\_\_\_\_


(Miscellaneous)

\_\_\_\_\_ Ft. from N. Line

510 Ft. from S. Line

\_\_\_\_\_ Ft. from E. Line

330 Ft. from W. Line

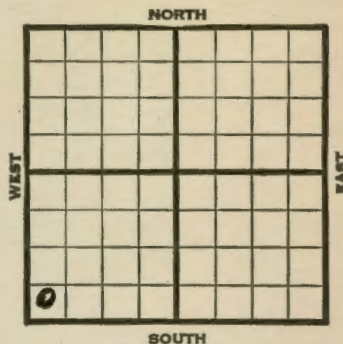

**NO-RECORD**

1939

REPORT

**O. W. D. D**

6/14

Old T.D. 654'  
Machine.

6/21

Squirrel Sand 674-91'  
T.D. 691'  
1/4 M cu. ft. gas.

**COMPLETED**

Douglas

KANSAS

Map No. NM Sec. 20 Twp. 13 R. 21E

Well No. 2 McBride

Goff Oil & Gas

Company

Contractor

COMPLETED

SW/C

Ft. from N. Line

510 Ft. from S. Line

Ft. from E. Line

330 Ft. from W. Line

MISCELLANEOUS

SECTION PLAT


Location

Rig up

Drilling and Remarks:

*Squid sand  
674-91*

*1/4 M Gas*

RECORD

Cased \_\_\_\_\_ in., \_\_\_\_\_ ft.

Sand \_\_\_\_\_

Gas \_\_\_\_\_

Oil \_\_\_\_\_

Total Depth 691

PRODUCTION

1st 24 hrs. Nat. \_\_\_\_\_

1st 24 hrs. after shot \_\_\_\_\_

Gas \_\_\_\_\_ Cu. Ft.

Dry Hole \_\_\_\_\_

Abandoned \_\_\_\_\_

Date

JUN 21 1939

19

S. J. LEWIS

Scout

Douglas

KANSAS

Map No. NM Sec. 20 Twp. 13 R. 21E

Well No. 2 McBride

Goff Oil & Gas

Company

Contractor

FIRST REPORT

SW/C

Ft. from N. Line

510 Ft. from S. Line

Ft. from E. Line

330 Ft. from W. Line

MISCELLANEOUS

SECTION PLAT


Location

**NO-RECORD**

Rig up

Drilling and Remarks:

OWDD - 654 TD

Mach.

RECORD

Cased \_\_\_\_\_ in., \_\_\_\_\_ ft.

Sand \_\_\_\_\_

Gas \_\_\_\_\_

Oil \_\_\_\_\_

Total Depth \_\_\_\_\_

PRODUCTION

1st 24 hrs. Nat. \_\_\_\_\_

1st 24 hrs. after shot \_\_\_\_\_

Gas \_\_\_\_\_ Cu. Ft.

Dry Hole \_\_\_\_\_

Abandoned \_\_\_\_\_

Date

JUN 14 1939

19

S. J. LEWIS

Scout