

KANSAS

Douglas


FORM 51 5M 10-41 PETROL

Section 18 Township 13 Range 21-E

Well No. #2 Durr

Company J. M. Edwards
Wildcat

868

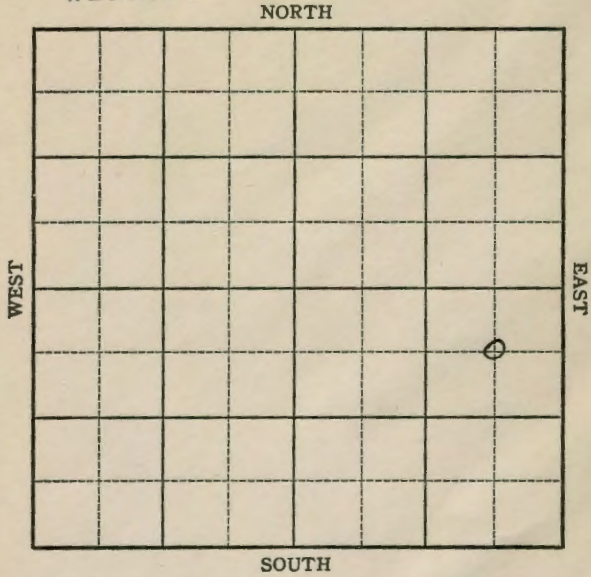

Form 252-A
5M 5-42 Petrol

KANSAS Douglas

Sec. 18 Twp. 13 R. 21-E

Well No. #2 Durr Farm


J. M. Edwards Company

660 Ft. from N. Line

_____ Ft. from S. Line

660 Ft. from E. Line

_____ Ft. from W. Line

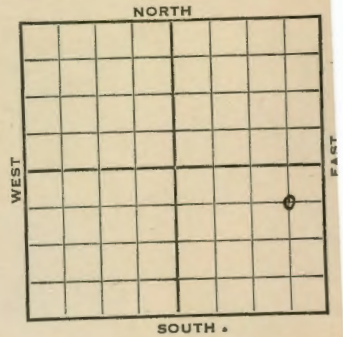

| REPORT | |
|--------|--------------------|
| 1942 | |
| 7/29 | Location |
| 8/5 | " |
| 8/12 | Abandoned location |

ABANDONED

Douglas

KANSAS

Map No. MM Sec. 18 Twp. 13 R. 21E

Well No. 2 Durr

J. M. Edwards Company

ABANDONED Contractor

C NE SE

SECTION PLAT

660 Ft. from N. Line

_____ Ft. from S. Line

660 Ft. from E. Line

_____ Ft. from W. Line

| | | | |
|--|--|--|---|
| | | | |
| | | | |
| | | | o |
| | | | |

WILDCAT

Location ✓

Rig up _____

Drilling and Remarks:

RECORD

Cased _____ in., _____ ft.

Sand _____

Gas _____

Oil _____

Total Depth _____

PRODUCTION

1st 24 hrs. Nat. _____

1st 24 hrs. after shot _____

Gas _____ Cu. Ft.

Dry Hole _____

Abandoned _____

Date

AUG 12 1942 19

S. J. LEWIS Scout

Douglas

KANSAS

Map No. MM Sec. 18 Twp. 13 R. 21E

Well No. 2 Durr

J. M. Edwards Company

FIRST REPORT Contractor

C NE SE

SECTION PLAT

660 Ft. from N. Line

_____ Ft. from S. Line

660 Ft. from E. Line

_____ Ft. from W. Line

| | | | |
|--|--|--|---|
| | | | |
| | | | |
| | | | o |
| | | | |

WILDCAT

Location XXX

Rig up _____

Drilling and Remarks:

RECORD

Cased _____ in., _____ ft.

Sand _____

Gas _____

Oil _____

Total Depth _____

PRODUCTION

1st 24 hrs. Nat. _____

1st 24 hrs. after shot _____

Gas _____ Cu. Ft.

Dry Hole _____

Abandoned _____

Date

JUL 29 1942 19

S. J. LEWIS Scout