

STATE CORPORATION COMMISSION OF KANSAS
OIL & GAS CONSERVATION DIVISION

WELL COMPLETION OR RECOMPLETION FORM
ACO-1 WELL HISTORY

DESCRIPTION OF WELL AND LEASE

Operator: license # 9203
name Rolex, Inc.
address 932 Massachusetts St.
Lawrence,
City/State/Zip ... Kansas ... 66044

Operator Contact Person Pat Haley
Phone (213) 254-3232

Contractor: license # 5304
name Gault Energy Corp.

Wellsite Geologist Pat Haley
Phone (213) 254-3232

PURCHASER

gnate Type of Completion

☐ New Well ☐ Re-Entry ☐ Workover

☐ Oil ☐ SWD ☐ Temp Abd
☐ Gas ☐ Inj ☐ Delayed Comp.
☒ Dry ☐ Other (Core, Water Supply etc.)

If OWWO: old well info as follows:

Operator
Well Name
Comp. Date Old Total Depth

WELL HISTORY

Drilling Method: ☐ Mud Rotary ☒ Air Rotary ☐ Cable

4/18/84 4/24/84 D&A 5/21/84
S, Date Date Reached TD Completion Date

685'
Total Depth PBD

A it of Surface Pipe Set and Cemented at 40 feet

Multiple Stage Cementing Collar Used? ☐ Yes ☒ No

If Yes, Show Depth Set feet

If alternate 2 completion, cement circulated
from 40 feet depth to Surface w/ 20 SX cmt

API NO. 15 - 045-20,502

County Douglas
SE SW SW NE
W/2 NE/4 Sec 29 Twp 13S Rge 21 XXX
(location)

2805 FSL 27805 Ft North from Southeast Corner of Section
2145 FEL 27145 Ft West from Southeast Corner of Section
(Note: locate well in section plat below)


Kcc record / LEO WLB
Lease Name Gerstenberger Well # 1

Field Name N/A

Producing Formation N/A

Elevation: Ground 840' KB

Section Plat

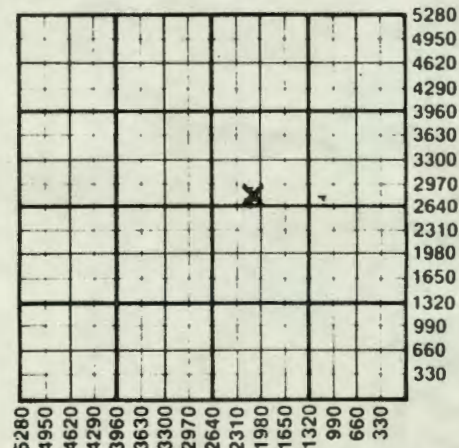

WATER SUPPLY INFORMATION

Source of Water:

Division of Water Resources Permit #

☐ Groundwater Ft North From Southeast Corner and
(Well) Ft. West From Southeast Corner of
Sec Twp Rge ☐ East ☐ West

☐ Surface Water 2700 Ft North From Southeast Corner and
(Stream, Pond etc.) 2100 Ft West From Southeast Corner
Sec 29 Twp 13 Rge 21 ☒ East ☐ West

☐ Other (explain)
(purchased from city, R.W.D.#)

Disposition of Produced Water: ☐ Disposal
☐ Repressuring

Docket #

INSTRUCTIONS: This form shall be completed in duplicate and filed with the Kansas Corporation Commission, 200 Colorado Derby Building, Wichita, Kansas 67202, within 90 days after completion or recompletion of any well. Rules 82-3-130 and 82-3-107 apply.

Information on side two of this form will be held confidential for a period of 12 months if requested in writing and submitted with the form. See rule 82-3-107 for confidentiality in excess of 12 months.

One copy of all wireline logs and drillers time log shall be attached with this form. Submit CP-4 form with all plugged wells. Submit CP-111 form with all temporarily abandoned wells.

29-13-21E

Operator Name Rolex, Inc. Lease Name Gerstenberger Well# 1 SEC 29 TWP 13 SRGE 21 ☒ East ☐ West

WELL LOG

INSTRUCTIONS: Show important tops and base of formations penetrated. Detail all cores. Report all drill stem tests giving interval tested, time tool open and closed, flowing and shut-in pressures, whether shut-in pressure reached static or hydrostatic pressures, bottom hole temperature, fluid recovery, and flow rates if gas to surface during test. Attach sheet if more space is needed. Attach copy of log.

Drill Stem Tests Taken
Samples Sent to Geological Survey
Cores Taken

☐ Yes ☐ No
☐ Yes ☐ No
☐ Yes ☐ No

Formation Description
☐ Log ☒ Sample

Name	Top	Bottom
Shale	483	492
Lime	492	493
Sand	493	496
Shale	496	503
Lime	503	504
Sandy Shale	504	512
Lime	512	520
Shale	520	524
Lime	524	525
Slate	525	526
Lime	526	527
Sand	527	530
Shale	530	537
Lime	537	539
Shale	539	558
Lime	558	562
Shale	562	565
Lime	565	567
Shale	567	568
Hand Sand	568	578
Shale	578	581
Red Shale	581	585
Shale	585	602
Lime	602	603
Sandy Shale	603	605
Lime	605	611
Shale	611	612
Sandy Shale (oil, 612-625)	612	653
Shale	653	664
Lime	664	665
Sandy Shale	665	666
Sand & Shale	666	685 TD

AUG 9 1984
State Geological Survey
WICHITA BRANCH

CASING RECORD

☐ new ☐ used

Report all strings set - conductor, surface, intermediate, production, etc.

Purpose of string	size hole drilled	size casing set (in O.D.)	weight lbs/ft.	setting depth	type of cement	# sacks used	type and percent additives

PERFORATION RECORD

Acid, Fracture, Shot, Cement Squeeze Record

specify footage of each interval perforated	(amount and kind of material used)	Depth