

STATE CORPORATION COMMISSION OF KANSAS
OIL & GAS CONSERVATION DIVISION

WELL COMPLETION OR RECOMPLETION FORM
ACO-1 WELL HISTORY

DESCRIPTION OF WELL AND LEASE

Operator: License # 6142
Name Tatum Oil Co.
Address Rt 4
Walla, Pa. 66071
City/State/Zip

Purchaser N/A

Operator Contact Person Lester Town
Phone 913 294-2125

Contractor: License # Ymb
Name R O Dilling

Wellsite Geologist.....
Phone.....

Designate Type of Completion

New Well Re-Entry Workover

OTI SWD Temp Abd
 Gas Inj Delayed Comp.
 Dry Other (Core, Water Supply etc.)

If OWWO: old well info as follows:

Operator,
Well Name,
Comp. Date, Old Total Depth.....

WELL HISTORY

Drilling Method:

Mud Rotary Air Rotary Cable

1-27-87 2-12-87 2-12-87
Spud Date Date Reached TD Completion Date

760 ,
Total Depth PBTD

Amount of Surface Pipe Set and Cemented at 20 feet
Multiple Stage Cementing Collar Used? Yes No

If yes, show depth set.....feet
If alternate 2 completion, cement circulated
from.....0 feet depth to.....20 w/3 SX cmt

API NO. 15-091-21,803
County Johnson
NE Sec 9 Twp 13 Rge 22 East West

4450 Ft North from Southeast Corner of Section
2475 Ft West from Southeast Corner of Section
(Note: Locate well in section plat below)


Lease Name Coker Well # 1

Field Name.....

Producing Formation.....

Elevation: Ground.....KB.....

Section Plat

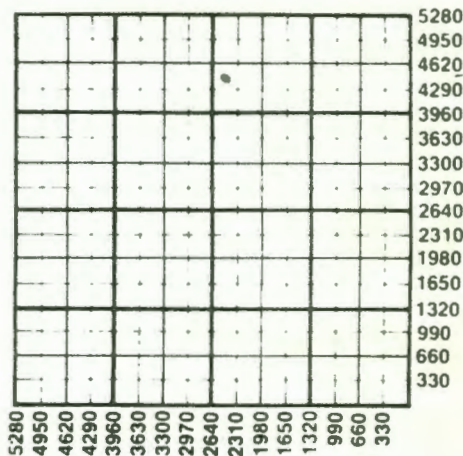

WATER SUPPLY INFORMATION

Disposition of Produced Water: Disposal
Docket # Repressuring

Questions on this portion of the ACO-1 call:

Water Resources Board (913) 296-3717

Source of Water:
Division of Water Resources Permit #.....

Groundwater.....Ft North from Southeast Corner
(Well)Ft West from Southeast Corner of
Sec Twp Rge East West

Surface Water.....Ft North from Southeast Corner
(Stream, pond etc).....Ft West from Southeast Corner
Sec Twp Rge East West

Other (explain).....
(purchased from city, R.W.D. #)

INSTRUCTIONS: This form shall be completed in duplicate and filed with the Kansas Corporation Commission, 200 Colorado Derby Building, Wichita, Kansas 67202, within 90 days after completion or recompletion of any well. Rule 82-3-130 and 82-3-107 apply.

Information on side two of this form will be held confidential for a period of 12 months if requested in writing and submitted with the form. See rule 82-3-107 for confidentiality in excess of 12 months.

One copy of all wireline logs and drillers time log shall be attached with this form. Submit CP-4 form with all plugged wells. Submit CP-111 form with all temporarily abandoned wells.

9-13-225

SIDE TWO

Operator Name Town Oil Lease Name Coker Well # 1

Sec. 9 Twp. 13 Rge. 22 East West County Johnson

WELL LOG

INSTRUCTIONS: Show important tops and base of formations penetrated. Detail all cores. Report all drill stem tests giving interval tested, time tool open and closed, flowing and shut-in pressures, whether shut-in pressure reached static level, hydrostatic pressures, bottom hole temperature, fluid recovery, and flow rates if gas to surface during test. Attach extra sheet if more space is needed. Attach copy of log.

Drill Stem Tests Taken Yes No
Samples Sent to Geological Survey Yes No
Cores Taken Yes No

Formation Description
 Log Sample

Name Top Bottom

see attached copy of log

CASING RECORD <input type="checkbox"/> New <input type="checkbox"/> Used							
Report all strings set-conductor, surface, intermediate, production, etc.							
Purpose of String	Size Hole Drilled	Size Casing Set (in O.D.)	Weight Lbs/Ft.	Setting Depth	Type of Cement	#Sacks Used	Type and Percent Additives
<u>Surface</u>	<u>9"</u>	<u>6 1/4</u>		<u>20'</u>	<u>Beston</u>	<u>5</u>	
PERFORATION RECORD				Acid, Fracture, Shot, Cement Squeeze Record			
Shots Per Foot	Specify Footage of Each Interval Perforated			(Amount and Kind of Material Used)			Depth
	<u>N/A</u>						
TUBING RECORD				Liner Run <input type="checkbox"/> Yes <input type="checkbox"/> No			
Size	Set At	Packer at					
Date of First Production		Producing Method					
		<input checked="" type="checkbox"/> Flowing <input type="checkbox"/> Pumping <input type="checkbox"/> Gas Lift <input type="checkbox"/> Other (explain).....					