


Johnson **KANSAS**

Section 27 Township 13 Range 22-E
 Well No. #1 Lyons
 Company F. O. McCain et al

NORTH **Miscellaneous**

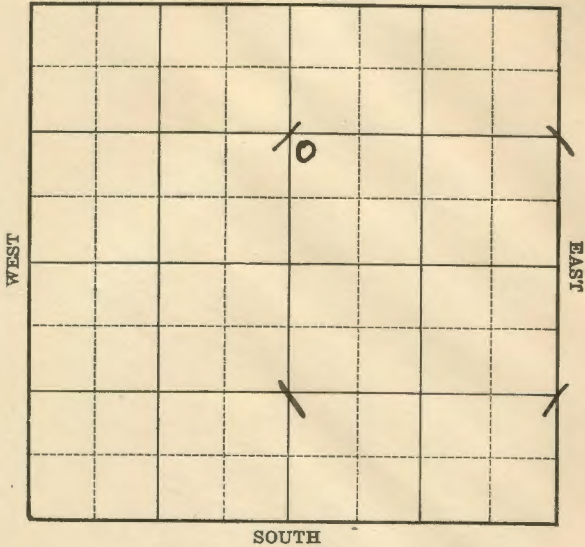


SOUTH

Johnson

Sec. 27 Twp. 13 R. 22-E
 Well No. #1 Lyons Farm _____
 Company F. O. McCain et al

(Miscellaneous)

_____ Ft. from N. Line
1170 Ft. from S. Line
 _____ Ft. from E. Line
150 Ft. from W. Line

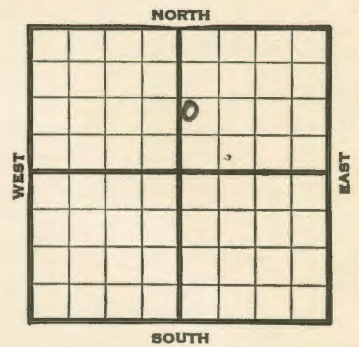

1939	REPORT
8/9	Drlg. 150'
8/17	T.D. 200' Fishing.
8/24	SD 345'
8/31	"
9/7	"
9/14	"
9/21	"
9/28	"
10/5	Drlg. 360'
10/14	6" - 550' TD 700' water.
10/18	Miss. 990'
	H.F.W.
	T.D. 1000'
	COMPLETED ABANDONED

Johnson

KANSAS

Map No. NM Sec. 27 Twp. 13 R. 22E

Well No. 1 Lyons

F. O. McCain etal Company
Contractor

ABANDONED

SECTION PLAT

NW SW NE
Ft. from N. Line
1170 Ft. from S. Line
Ft. from E. Line
150 Ft. from W. Line

		o	

MISCELLANEOUS

Location _____

RECORD

Cased _____ in., _____ ft.
Sand _____
Gas _____
Oil _____
Total Depth 1000

PRODUCTION

1st 24 hrs. Nat. _____
1st 24 hrs. after shot _____
Gas _____ Cu. Ft.
Dry Hole _____
Abandoned _____

Date
OCT 18 1939 19

S. J. LEWIS Scout

*Miss 990
HFW*

Johnson

KANSAS

Map No. NM Sec. 27 Twp. 13 R. 22E

Well No. 1 Lyons

F. O. McCain etal Company
Contractor

FIRST REPORT

SECTION PLAT

NW SW NE
Ft. from N. Line
1170 Ft. from S. Line
Ft. from E. Line
150 Ft. from W. Line

		o	

MISCELLANEOUS

Location _____

RECORD

Cased _____ in., _____ ft.
Sand _____
Gas _____
Oil _____
Total Depth _____

PRODUCTION

1st 24 hrs. Nat. _____
1st 24 hrs. after shot _____
Gas _____ Cu. Ft.
Dry Hole _____
Abandoned _____

Date
AUG 9 1939 19

S. J. LEWIS Scout

