GEOLOGICAL DEPARTMENT **UNION GAS CORPORATION** INDEPENDENCE, KANSAS

SAMPLE

Elevation	Depth	
664+	278	664+ S.L.E.
	279	
	280	
	281	Show
	282	
	283	21M
	284	
	285	
	286	21M
	287	
	288	
	289	48M
	290	
	291	
	292	
	293	77M
	294	
	295	
	296	151M
	297	
	298	
	299	
	300	171M
	301	
641+	302'4	171M 641+ S.L.E.

S. T. R. 16-13-23
County Johnson
State Kansas
Company Sagamore Oil and Gas Co.
Lease and Well No. Enright #1-B
Location 660'S-620'E NW cor SW1/4
Drilling Completed 9/16/35
Initial Production 171M - 102# R.P.
Surface Elevation 942.5 Gd

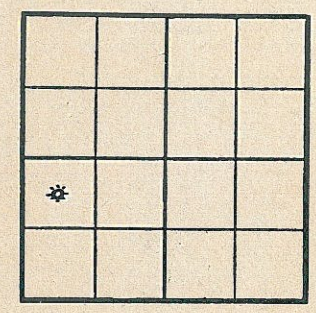

Geological Form 3