

SAGAMORE OIL AND GAS COMPANY
INDEPENDENCE, KANSAS

2-13-23E

Company **Dunbar and Shea**

S. T. R. **2-13-23**
County **Johnson**
State **Kansas**
Lease and Well No. **Anderson #1**

Contractor

Drilling
Commenced


Drilling
Completed

Initial
Production

Initial Rock
Pressure

Location **INT 3E4 (660' SL-660' NL)**

Casing

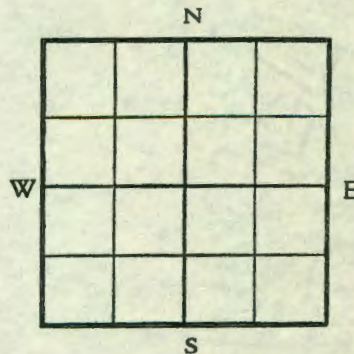

Driller's Record of Formations

T.D. **No showing** **700**