
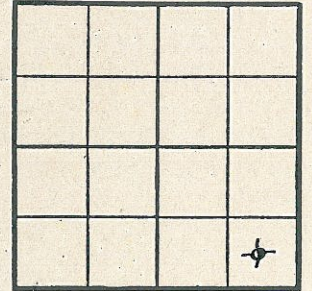


Elevation	SAMPLE	Depth	661 ⁺ S.L.E	S. T. R.	17-13-23
		282		County	Johnson
		283		State	Kansas
		284		Company	Sagamore Oil and Gas Co.
		285		Lease and Well No.	Thomas Atkinson #1
		286		Location	Center SE 1/4 - SE 1/4
		287		Drilling Completed	Sept. 21, 1935
		288		Initial Production	Dry
		289		Surface Elevation	943.4 Gid
		290			
		291			
611⁺ S.L.E

Elevation	SAMPLE	Depth	
		332	611 ⁺ S.E. S. T. R. 17-13-23
		333	County Johnson
		334	State Kansas
		335	Company Thomas Atkinson #1
		336	Lease and Well No. Sagamore Oil & Gas Co.
		337	Location Center S.E. 1/4 - S.E. 1/4
		338	Drilling Completed Sept. 21, 1935
		339	Initial Production Dry
			Surface Elevation 943.4 6 1/4

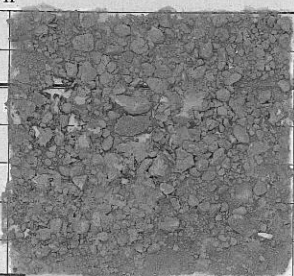