

20-13-2358

SIDE ONE

STATE CORPORATION COMMISSION OF KANSAS
OIL & GAS CONSERVATION DIVISION

WELL COMPLETION OR RECOMPLETION FORM
ACO-1 WELL HISTORY

DESCRIPTION OF WELL AND LEASE

Operator: License # 6146
Name Cedar Creek Properties
Address Box 25900
Overland Park, KS 66225
City/State/Zip

Purchaser Domestic Use

Operator Contact Person Charles Nichols
Phone 913-722-5998

Tractor: License #
Name

Wellsite Geologist Charles Nichols
Phone 913-722-5998

Designate Type of Completion

☒ New Well ☐ Re-Entry ☐ Workover

☐ Oil ☐ SWD ☒ Temp Abd
☒ Gas ☐ Inj ☐ Delayed Comp.
☐ Dry ☐ Other (Core, Water Supply etc.)

If OWWO: old well info as follows:

Operator
Well Name
Comp. Date Old Total Depth

WELL HISTORY

Drilling Method:

☒ Mud Rotary ☐ Air Rotary ☐ Cable

9-9-82 9/9/82 7/20/83
Date Date Reached TD Completion Date

499.8
Total Depth PBTD

Amount of Surface Pipe Set and Cemented at 50 feet
Multiple Stage Cementing Collar Used? ☐ Yes ☒ No
If yes, show depth set feet
If alternate 2 completion, cement circulated
from feet depth to w/ SX cmt

API NO. 15-091-20,857
County Johnson

..... NW 1/4 Sec 20 Twp. 13S Rge. 23 ☒ East ☐ West

3300 Ft North from Southeast Corner of Section
2970 Ft West from Southeast Corner of Section
(Note: Locate well in section plat below)


Lease Name Cedar Creek Well # 1

Field Name

Producing Formation Bartlesville Sand

Elevation: Ground KB

Section Plat

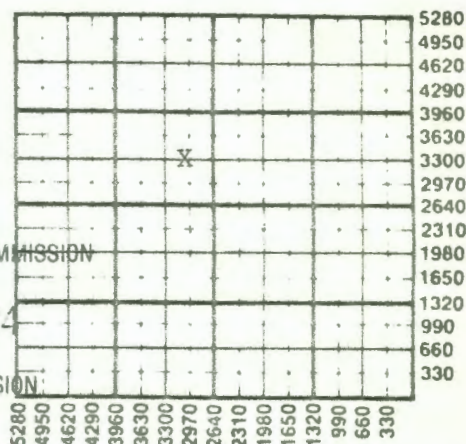

RECEIVED
STATE CORPORATION COMMISSION
NOV 13 1984
WICHITA, KANSAS

WATER SUPPLY INFORMATION

Disposition of Produced Water: ☐ Disposal
Docket # N/A ☐ Repressuring

Questions on this portion of the ACO-1 call:
Water Resources Board (913) 296-3717

Source of Water:
Division of Water Resources Permit #

☐ Groundwater Ft North from Southeast Corner
(Well) Ft West from Southeast Corner of
Sec Twp Rge ☐ East ☐ West

☐ Surface Water Ft North from Southeast Corner
(Stream, pond etc) Ft West from Southeast Corner
Sec Twp Rge ☐ East ☐ West

☐ Other (explain)
(purchased from city, R.W.D. #)

INSTRUCTIONS: This form shall be completed in duplicate and filed with the Kansas Corporation Commission, 200 Colorado Derby Building, Wichita, Kansas 67202, within 90 days after completion or recompletion of any well. Rule 82-3-130 and 82-3-107 apply.

Information on side two of this form will be held confidential for a period of 12 months if requested in writing and submitted with the form. See rule 82-3-107 for confidentiality in excess of 12 months. One copy of all wireline logs and drillers time log shall be attached with this form. Submit CP-4 form with all plugged wells. Submit CP-111 form with all temporarily abandoned wells.

SIDE TWO

Operator Name Cedar Creek Properties Lease Name Cedar Creek Well # 1

Sec. 20 Twp. 13S Rge. 23 ☒ East ☐ West County Johnson

WELL LOG

INSTRUCTIONS: Show important tops and base of formations penetrated. Detail all cores. Report all drill stem tests giving interval tested, time tool open and closed, flowing and shut-in pressures, whether shut-in pressure reached static level, hydrostatic pressures, bottom hole temperature, fluid recovery, and flow rate if gas to surface during test. Attach extra sheet if more space is needed. Attach copy of log.

Drill Stem Tests Taken ☐ Yes ☒ No
Samples Sent to Geological Survey ☐ Yes ☒ No
Cores Taken ☐ Yes ☒ No

Formation Description
☐ Log ☐ Sample

Name Top Bottom

Information not available
Kc-Kcl

CASING RECORD ☒ New ☐ Used							
Report all strings set-conductor, surface, intermediate, production, etc.							
Purpose of String	Size Hole Drilled	Size Casing Set (in O.D.)	Weight Lbs/Ft.	Setting Depth	Type of Cement	#Sacks Used	Type and Percent Additives
Ground water	8"	6"		50'		8	
Protection		2 1/2"		499.8		84	

PERFORATION RECORD		Acid, Fracture, Shot, Cement Squeeze Record	
Shots Per Foot	Specify Footage of Each Interval Perforated	(Amount and Kind of Material Used)	Depth
2	440. - 445		

TUBING RECORD		Liner Run ☐ Yes ☐ No	
Size	Set At	Packer at	

Date of First Production | Producing Method