

TYPE

AFFIDAVIT OF COMPLETION FORM

ACO-1 WELL HISTORY

30-13-23E

Compt. end

SIDE ONE

Two (2) copies of this form shall be filed with the Kansas Corporation Commission, 200 Colorado Derby Building, Wichita, Kansas 67202, within thirty (30) days after the completion of a well, regardless of how the well was completed.

F Attach separate letter of request if the information is to be held confidential. If confidential, only file one copy. Information on Side One will be of public record and Side Two will then be held confidential.

Applications must be made on dual completion, commingling, salt water disposal, injection and temporarily abandoned wells.


C Attach one copy only wireline logs (i.e. electrical log, sonic log, gamma ray neutron log, etc.). (Rules 82-2-105 & 82-2-125) KCC# (316) 263-3238.

LICENSE # 6912 EXPIRATION DATE 6-30-83
OPERATOR Prairie Center Gas & Oil Inc API NO. 15-091-20,499
ADDRESS 810 W. 56th Way COUNTY Johnson
Olathe, Kansas 66061 FIELD _____
** CONTACT PERSON Larry R Trammell PROD. FORMATION Wayside
PHONE 782-0771

PURCHASER _____ LEASE Florence Schanze
ADDRESS _____ WELL NO. 2

DRILLING CONTRACTOR A.G. Glaze Drilling WELL LOCATION SW SE SW
ADDRESS 15710 S. Woodland Road 165 Ft. from South Line and
Olathe, KS 66062 700 Ft. from East Line of
the SW (Qtr.) SEC 30 TWP 13 RGE 23 (E) (W)

PLUGGING CONTRACTOR _____
ADDRESS _____

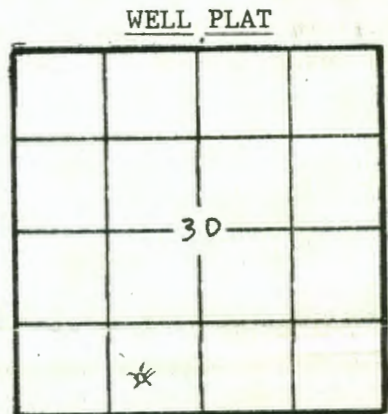

(Office Use Only)
KCC _____
KGS
SWD/REP _____
PLG. _____

TOTAL DEPTH 505.7 PBTD _____

SPUD DATE 10-22-81 DATE COMPLETED 12-20-82

ELEV: GR 1035 DF _____ KB _____

DRILLED WITH (CABLE) (ROTARY) (AIR) TOOLS.

DOCKET NO. OF DISPOSAL OR REPRESSURING WELL BEING USED TO DISPOSE OF WATER FROM THIS LEASE _____

Amount of surface pipe set and cemented 27 DV Tool Used? NO

THIS AFFIDAVIT APPLIES TO: (Circle ONE) - Oil, Gas, Shut-in Gas, Dry, Disposal, Injection, Temporarily Abandoned, OWWO. Other _____

ALL REQUIREMENTS OF THE STATUTES, RULES AND REGULATIONS PROMULGATED TO REGULATE THE OIL AND GAS INDUSTRY HAVE BEEN FULLY COMPLIED WITH.

A F F I D A V I T Oil, Inc.

Larry R. Trammell, Sec. Prairie Center Gas & Oil being of lawful age, hereby certifies that:

I am the Affiant, and I am familiar with the contents of the foregoing Affidavit. The statements and allegations contained therein are true and correct.

Prairie Center Gas & Oil, Inc.

By: Larry R Trammell
Larry R Trammell, Sec.

State Geological Survey
WICHITA BRANCH

NOTARY PUBLIC

18

OPERATOR Prairie center gas & oil inc LEASE Schanze

SEC. 50 TWP. 13 RGE. 25

FILL IN WELL INFORMATION AS REQUIRED: WELL NO. _____

Show all important zones of porosity and contents thereof; cored intervals, and all drill-stem tests, including depth interval tested, cushion used, time tool open, flowing and shut-in pressures, and recoveries.

SHOW GEOLOGICAL MARKERS, LOGS RUN, OR OTHER DESCRIPTIVE INFORMATION.

FORMATION DESCRIPTION, CONTENTS, ETC.	TOP	BOTTOM	NAME	DEPTH
<input checked="" type="checkbox"/> Check if no Drill Stem Tests Run.				

Sutton Geological Survey
WICHITA BRANCH

ACID, FRACTURE, SHOT, CEMENT SQUEEZE RECORD

Amount and kind of material used		Depth interval treated
Sand - 25 sacks AK-15 - 2 gal		444 - 460
Postassium chloride salt		
water gel salt		
Date of first production	Producing method (flowing, pumping, gas lift, etc.)	Gravity
Estimated Production -I.P.	Oil bbls. Gas MCF Water %	Gas-oil ratio CFPB
Disposition of gas (vented, used on lease or sold)		Perforations

Report of all strings set— surface, intermediate, production, etc. CASING RECORD (New) or (Used)

Purpose of string	Size hole drilled	Size casing set (in O.D.)	Weight lbs/ft.	Setting depth	Type cement	Socks	Type and percent additives
surface		7"	20 lb	24'	Common	5	2% CaCl
Production		2 3/8"	4.75 lb	5057'	Common	102	

LINER RECORD

PERFORATION RECORD

Top, ft.	Bottom, ft.	Sacks cement	Shots per ft.	Size & type	Depth interval
----------	-------------	--------------	---------------	-------------	----------------

TUBING RECORD

Size 2 3/8	Setting depth 5057'	Packer set at 5057'	2	1 1/2" sleeve	444-460
------------	---------------------	---------------------	---	---------------	---------