

33-13-23E Ind. pl

TYPE

AFFIDAVIT OF COMPLETION FORM

ACO-1 WELL HISTORY

Compt. _____

SIDE ONE

(Rules 82-3-130 and 82-3-107)

DOCKET NO. NP _____

This form shall be filed with the Kansas Corporation Commission, 200 Colorado Derby Building, Wichita, Kansas 67202, within ninety (90) days after the completion of a well, regardless of how the well was completed.

FOR INFORMATION REGARDING THE NUMBER OF COPIES TO BE FILED AND APPLICATIONS REQUIRING COPIES OF ACO-1 FORMS SEE PAGE TWO (2), SIDE TWO (2) OF THIS FORM.

F Letter requesting confidentiality attached.

C Attach ONE COPY of EACH wireline log run (i.e. electrical log, sonic log, gamma ray neutron log etc.)***Check here if NO logs were run _____.

PLEASE FILL IN ALL INFORMATION. IF NOT AVAILABLE, INDICATE. IF INFORMATION LATER BECOMES AVAILABLE, SUBMIT BY LETTER.

LICENSE # 8844 EXPIRATION DATE Feb 15 1984

OPERATOR DanRanco LTD Inc API NO. 15-091-21,100

ADDRESS 5430 NW 42 COUNTY Johnson

Okla City Okla 73122 FIELD Olathe

** CONTACT PERSON Randy Cobb PROD. FORMATION Lower Squirrel & Krubter
PHONE 405 495 0015 Indicate if new pay.

PURCHASER Union Gas System Inc LEASE Blenkley


ADDRESS Independence Ks WELL NO. 5

DRILLING CONTRACTOR AG Glaze Drilling Co 1150 Ft. from S Line and

ADDRESS Olathe Ks 2310 Ft. from E Line of

the SE (Qtr.) SEC 35 TWP 13 RGE 23 SE

PLUGGING CONTRACTOR _____
ADDRESS _____

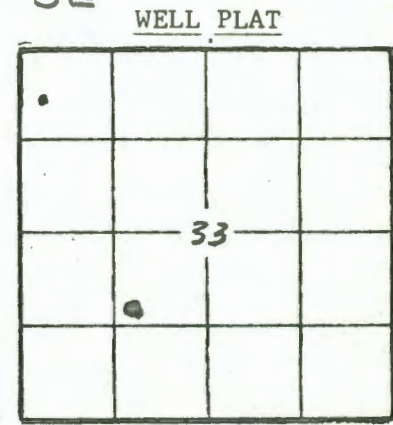

(Office Use Only)
KCC _____
KGS
SWD/REP _____
PLG. _____
NGPA _____

TOTAL DEPTH 830 PBD 265

SPUD DATE 8/13/83 DATE COMPLETED 12/16/83

ELEV: GR None DF _____ KB _____

DRILLED WITH (CABLE) (ROTARY) (AIR) TOOLS.

DOCKET NO. OF DISPOSAL OR REPRESSURING WELL BEING USED TO DISPOSE OF WATER FROM THIS LEASE None.

Amount of surface pipe set and cemented 21 DV Tool Used? NO Cemented to Sur

TYPE OF COMPLETION THIS AFFIDAVIT APPLIES TO: (Circle ONE) - Oil, Shut-in Gas, Gas, Dry, Disposal, Injection, Temporarily Abandoned. If OWWO, indicate type of re-completion _____. Other completion _____. NGPA filing _____.

ALL REQUIREMENTS OF THE STATUTES, RULES AND REGULATIONS PROMULGATED TO REGULATE THE OIL AND GAS INDUSTRY HAVE BEEN FULLY COMPLIED WITH.

A F F I D A V I T

Randy Cobb

that _____, being of lawful age, hereby certifies

528163

ACO-1 Well History

Side TWO OPERATOR Danawoo LTD Inc LEASE NAME Blenkley SEC 33 TWP 13 RGE 27 (W) WELL NO 5

FILL IN WELL INFORMATION AS REQUIRED:

Show all important zones of porosity and contents thereof; cored intervals, and all drill-stem tests, including depth interval tested, cushion used, time tool open, flowing and shut-in pressures, and recoveries.

Show Geological markers, logs run, or other Descriptive information.

| Formation description, contents, etc. | Top | Bottom | Name | Depth |
|--|-----|--------|---------------|-------|
| <input checked="" type="checkbox"/> Check if no Drill Stem Tests Run. <input type="checkbox"/> Check if samples sent Geological Survey. Ran Induction & Density Logs | 360 | 372 | Knobtown | |
| | 682 | 688 | Lower Squared | |

ACID, FRACTURE, SHOT, CEMENT SQUEEZE RECORD

| Amount and kind of material used | Depth interval treated |
|---|------------------------|
| 8000 LB 10/20 12/30 Sand w/ 160 BB/c 2% Gel/HCl | 682 688 |
| | 360 372 |

| | | |
|--|---|------------------------------|
| Date of first production <u>None</u> | Producing method (flowing, pumping, gas lift, etc.) | Gravity |
| Estimated Production-L.P. | Gas 250 000 MCF | Water % |
| Disposition of gas (vented, used on lease or sold) | <u>Shot in</u> | Gas-oil ratio |
| | | 682 688 360 372 Perforations |

Report of all strings set—surface, intermediate, production, etc. CASING RECORD (New) or (Used)

| Purpose of string | Size hole drilled | Size casing set (in O.D.) | Weight lbs/ft. | Setting depth | Type cement | Sacks | Type and percent additives |
|-------------------|-------------------|---------------------------|----------------|---------------|-------------|-------|----------------------------|
| Surface | 8 1/2 | 7 | ? | 21 | Poly Mix | 3 | |
| Production | 6 1/2 | 4 1/2 | 8.5 | 765 | Class Hc | 88 | |

LINER RECORD

PERFORATION RECORD

| Top, ft. | Bottom, ft. | Sacks cement | Shots per ft. | Size & type | Depth interval |
|----------|-------------|--------------|---------------|----------------|----------------|
| | | | 2 SPF | Casing Gun Jet | 682 688 |
| | | | 1 SPF | " " | 360 372 |