


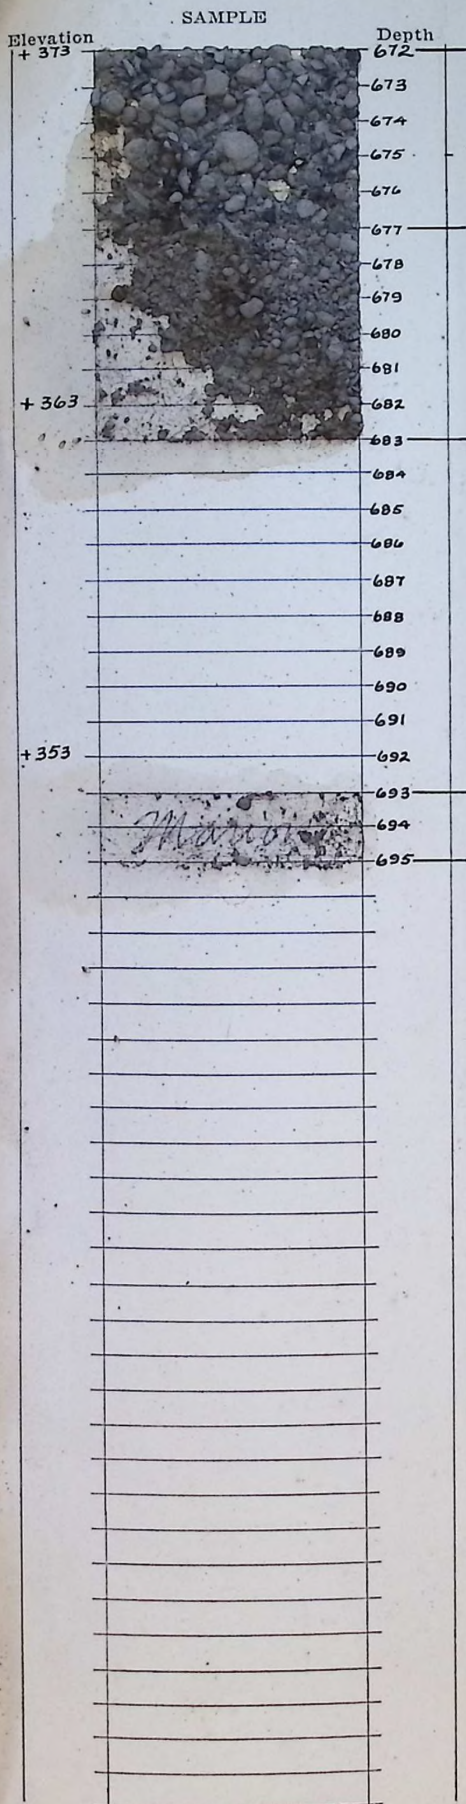

Top of Gas Sand.

675-677
44,000677-683
62,000

T.D. Plugged Back to 687

S. T. R. 3-13-23

County Johnson

State Kansas

Company Union Gas Corporation

Lease and Well No. Hy. C. Douglas #1

Location 660 N. 660 E. SW 4

Drilling Completed 2/8/28

Initial Production 62,000 Cu. Ft. Gas Well

Surface Elevation 1044.0' grd.

