



Map No. **KANSAS** Sec. \_\_\_\_\_ Twp. \_\_\_\_\_ R. \_\_\_\_\_

Well No. \_\_\_\_\_ Farm \_\_\_\_\_


\_\_\_\_\_ Company \_\_\_\_\_

\_\_\_\_\_ Ft. from N. Line

\_\_\_\_\_ Ft. from S. Line

\_\_\_\_\_ Ft. from E. Line

\_\_\_\_\_ Ft. from W. Line

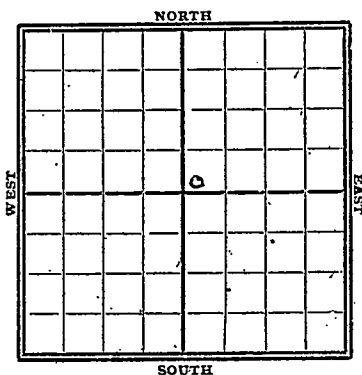

1919

Date

REPORT

7/24

*Gypsy Records*

*T.S. 2431*

*Small show oil*

*Barren 2434-47'*

*H F W.*

*Abd T.D. 2665*

Dickerson

MAP No. KANSAS SEC. 29 TWP. 11S R. 3E

WELL No. Near Wakefield

Kanso COMPANY

1st well CONTRACTOR

SECTION PLAT

		0	

~~ABANDONED~~

\_\_\_\_\_ FT. FROM N. LINE

\_\_\_\_\_ FT. FROM S. LINE

\_\_\_\_\_ FT. FROM E. LINE

\_\_\_\_\_ FT. FROM W. LINE

LOCATION \_\_\_\_\_

RIG UP \_\_\_\_\_

DRILLING AND REMARKS:

*Top of sand*

*2431' small*

*chance of oil*

*2435' } borer*

*2447' } H. W.*

RECORD

CASED \_\_\_\_\_ IN. \_\_\_\_\_ FT.

SAND \_\_\_\_\_

GAS \_\_\_\_\_

OIL \_\_\_\_\_

TOTAL DEPTH 2665

PRODUCTION

1ST 24 HRS. NAT. \_\_\_\_\_

1ST 24 HRS. AFTER SHOT \_\_\_\_\_

GAS \_\_\_\_\_ CU. FT.

DRY HOLE \_\_\_\_\_

ABANDONED \_\_\_\_\_

DATE

7/24 1919

SCOUT