


KANSAS

Map No. Sec. 17 Twp. 13 R. 4E

Well No. 1- Widdhl Farm

STEINBUCHER et al Company

NORTH

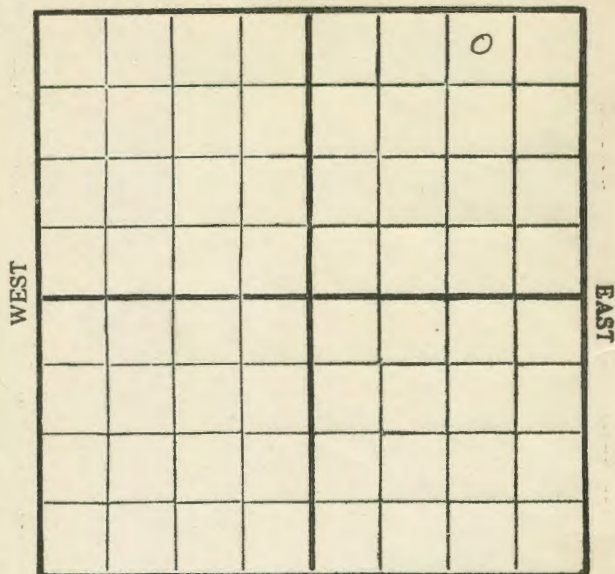

SOUTH

Location
Drilling RemarksRig Up
Drilling Remarks

RECORD

Cased _____ in. _____ ft.
 Sand _____
 Gas _____
 Oil _____
 Total Depth _____

PRODUCTION

1st 24 hrs. Nat. _____
 1st 24 hrs. after shot _____
 Gas _____ cu. ft. _____
 Dry Hole _____
 Abandoned _____

KANSAS

Map No. Sec. 17 Twp. 13 R. 4E

Well No. 1- Widdhl Farm

STEINBUCHER et al Company


NORTH

330 Ft. from N. Line

Ft. from S. Line

990 Ft. from E. Line

Ft. from W. Line

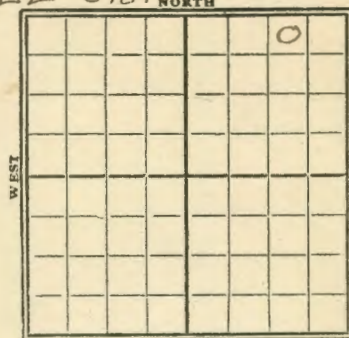

SOUTH

1929

Date

REPORT

8/21 Location
 8/28 Rig
 9/4 Rig up
 9/11 Shdgy.
 9/18 Drly 630'
 9/25 " 1400'
 10/2 fsg 1530'
 10/9 fsg 1600'
 10/16 SD 1600'
 10/23
 10/30
 11/6 Drly 1705'
 11/13 SD 2035'
 11/20 fsg 6"-2090'
 11/27 Drly 2095'
 12/4 UIR 6"-2160'
 12/11 Chat 2158-2200'
 HFW 2175 - UIR 6"
 12/23 Top chat 2125
 Base line 2230'
 drly 2345
 (over)

2/30- Sandy lime 2345'-2400'
had HFW-UIR6"-2390'

1930

1/7 —

1/15 —

1/22- S.D. 2400' HFW

1/29- set 6"-2410' HFW 2440'
S.D. 2650'

2/4- —

2/11- —

2/19- Drly 2720'

2/26- S.D. 2750'

3/12- —

3/19- —

3/26- —

4/2- 5" at 2751' HFW

2780' Drly 2805

4/9- Top Viola 2765

Wilcox 2872-97

Sile. line 2935-43

S.D.

4/16- Top Viola 2765

" Wilcox 2872-97

Sile. line 2935-46

TD 2946 HFW

Abandon

Dickinson E

Map No. **KANSAS** Sec. 17 Twp. 13 R. 4
101 Well No. 1 Diddle

Bruegar et al Company
Contractor

FIRST REPORTS

SECTION PLAT

330 Ft. from N. Line

Ft. from S. Line

990 Ft. from E. Line

Ft. from W. Line

			0

Location ☒

Rig up

Drilling and Remarks:

RECORD

Cased in., ft.

Sand

Gas

Oil

Total Depth

PRODUCTION

1st 24 hrs. Nat.

1st 24 hrs. after shot

Gas Cu. Ft.

Dry Hole

Abandoned

Date

8/71

1929


CHAS. L. SHERWOOD

Scout

Dickinson
 101 Kns Sec. 17 Twp. 13 R. 4^E
 Map No. _____
 Well No. 1 Dishel
 Steinbuechel et al Company
 Contractor

SECTION PLAT

330 Ft. from N. Line
 _____ Ft. from S. Line
 990 Ft. from E. Line
 _____ Ft. from W. Line

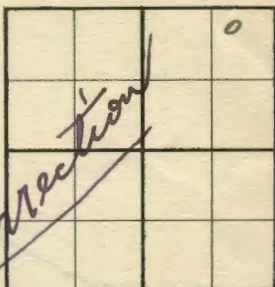

Location _____

Rig up *by 1400'*

Drilling and Remarks:

chy ownership

RECORD

Cased _____ in., _____ ft.
 Sand _____
 Gas _____
 Oil _____
 Total Depth _____

PRODUCTION

1st 24 hrs. Nat. _____
 1st 24 hrs. after shot _____
 Gas _____ Cu. Ft.
 Dry Hole _____
 Abandoned _____

Date


9/15/29 19 *Chas. L. Sherwood* Scout

Dickinson
 101 KANSAS Sec. 17 Twp. 13 R. 4^E
 Map No. _____
 Well No. 1 Dishel
 Steinbuechel et al Company
 Contractor

COMPLETE

SECTION PLAT

330 Ft. from N. Line
 _____ Ft. from S. Line
 990 Ft. from E. Line
 _____ Ft. from W. Line

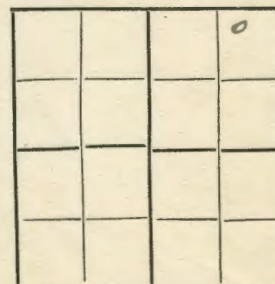

ABANDONED

Location _____

Rig up _____

Drilling and Remarks:

Top Viola 2765
Wilecox 2872-97
Silc lime 2935-48
HW

RECORD

Cased _____ in., _____ ft.
 Sand _____
 Gas _____
 Oil _____
 Total Depth *2946*

PRODUCTION

1st 24 hrs. Nat. _____
 1st 24 hrs. after shot _____
 Gas _____ Cu. Ft.
 Dry Hole ☒
 Abandoned ☒

Date

APR 16 1930
 192 *CHAS. L. SHERWOOD* Scout