


10" 20"  
 8 1-4 15 1-2  
 6 5-8 12 1-2  
 5 3-16  
 TOTAL DEPTH 2382'

FARM K. L. Foster  
 COMPANY Manhattan Oil Co.  
 CONTRACTOR  
 COMMENCED 6-7-27

NO. 1 COUNTY Geary  
 COMPLETED 8-2-27.  
 SHOT QUARTS BETWEEN

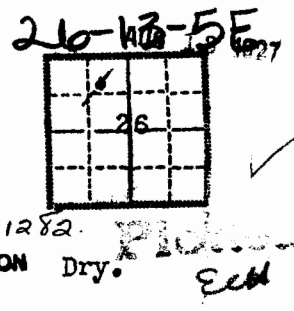

CORRESPONDENCE REGARDING THIS WELL SHOULD BE REFERRED TO Manhattan Oil Co.,  
 Eureka, Kansas.  
 FIGURES INDICATE BOTTOM OF FORMATIONS.  
 REMARKS 8/13/27.

ELEVATION 1282  
 INITIAL PRODUCTION Dry. Eck

Formation	Depth	Formation	Depth	Formation	Depth
soil yellow	4	(Set 940' 12 1/2" csg. SLM) slate blue	960	(Bad cave from 1949- 2020' lime white	970
lime white	8	line white	970	(HFW from 2050 to 2060') sandy lime	2100
shale blue	18	slate blue 6 BW fr	1005	lime white	2118
lime shells (1/2 B. W. per hr 70')	85	water sand 1005-25'	1025	shale green	2122
slate white	95	slate blue (HFW fr 1365 to 1385')	1040	shale red	2135
red rock	110	lime white	1077'	Set 2282' 6 5/8" csg.) shale blue	2287
slate blue	133	slate white	1115	(Underreamed to 2305') lime white	2290
slate white	145	lime white	1140	( HFW from 2290 to 2300') sand white	2300
sandy lime	155	shale green	1165	lime white	2359
slate blue	170	lime white	1177	sand white	2382
(Set 317' 15 1/2" csg. SLM lime white	180	shale blue	1195	(HFW from 2359 to 2382 slate blue	1238
slate blue	190	lime white	1238	SLM) lime white	1241
lime shells	210	shale blue	1241	Total Depth	2382'
red rock	220	lime white	1259		
(HFW at 720') lime white	235	shale blue	1270		
slate blue	250	lime white	1315		
lime white	258	slate white	1318		
slate blue	260	lime white	1320		
lime sandy	268	slate brown	1323		
slate white	275	lime white	1333		
lime shells (12 1/2" csg. SLM.)	317	slate white	1356		
lime white	342	water sand	1385		
red rock	355	sandy shale	1390		
lime white	365	sand white	1500		
slate white	370	slate white	1504		
lime white	375	lime white	1551		
shale blue	377	slate blue	1577		
lime white	382	lime white	1600		
shale pink	400	slate white	1603		
lime white	460	lime white	1608		
slate blue	490	slate white	1611		
lime white	494	sand white	1614		
slate white	509	slate white	1624		
shale blue	525	lime sandy	1644		
shale white	535	shale blue	1647		
lime white	540	(Set 1649' 10" csg. SLM) lime white	1650		
slate blue	555	shale blue	1653		
lime sandy	565	(Small cave at 1653') lime white	1675		
slate blue	590	shale blue	1688		
slate white	615	lime white	1772		
lime white	620	shale blue	1785		
shale blue	675	lime white	1810		
water sand HFW	720	shale blue	1820		
shale blue	808	lime white	1840		
lime white	816	slate blue	1858		
shale blue	820	lime black	1862		
lime white	836	lime white	1878		
shale blue	838	(Bad cave from 1878 to lime white	1900'		
shale blue	843	shale blue	1900		
lime white	858	shale shells	1920		
shale blue	865	shale pink	1935		
sand white	880	shale white	2020		
shale blue	885	(Set 1949' 8 1/4" csg.) shale green	900		
shale green	910	(Underreamed to 2027' SLM) lime white	910		
shale blue	918	lime white	2028		
slate white	922	chat white	2060		

Ballard Samples  
 T.M. 2220  
 T.K. 2115  
 T.H. 2286