

M

KANSAS

Geary


15-061-00001

Section 36 Township 13 Range 5E

Well No. 1 Sullivant

Company Hayrock Oil

Wildcat NORTH

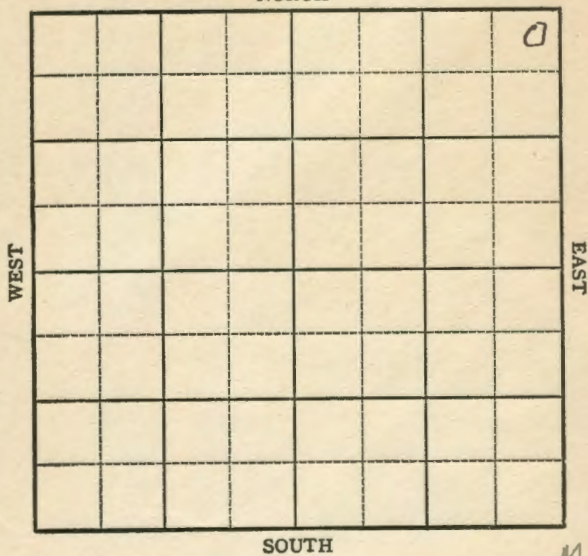

M

KANSAS

Geary

Sec. 36 Twp. 13 R. 5E ✓

Well No. #1 Sullivant Farm

Hayrock Oil

Company

Wildcat


330' Ft. from N. Line

Ft. from S. Line

330' Ft. from E. Line

Ft. from W. Line

NE/C

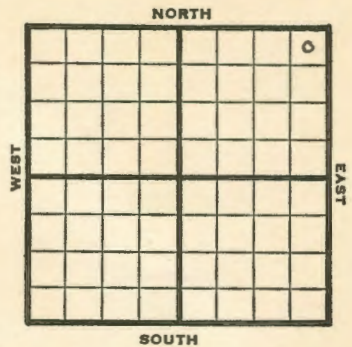

1948

Elev 1345'

REPORT

Date	Location
9/8	Location
9/14	"
9/21	"
9/29	"
10/6	"
10/13	"
10/19	"
10/26	"
11/3	"
11/10	"
11/16	"
11/23	"
11/30	"
12/8	"
12/15	"
12/22	"
12/29	"
1/5	"
1/12	"
1/19	"
1/26	"
2/2	"
2/9	Location
2/16	"
2/23	Drlg 200'
3/2	Drlg 810'

OVER

1949  
3/8 15" @ 184'  
Drlg 1035'  
3/16 10" @ 1300'  
KC 1480'  
Drlg 1490'  
3/23 8" @ 1970' Drlg.  
3/30 8" @ 2090'  
Drlg 2125'  
4/6 Miss 2060'  
TD 2610'  
Water.  
4/12 Hunton 2325  
7" @ 2315'  
TD 2410'  
4/20 Viola 2590'?  
SD 2600'  
4/27 5" @ 2730'  
CO  
5/4 Simpson 2792'  
Drlg 2906'  
5/10 Granite 3030'  
TD 3042'  
PB 2760'  
5/18 "  
/25 TD 3042'  
Granite 3030'  
Aband.

**ABANDONED**

