


Section 23 Township 13 Range 8EWell No. 1 FalkCompany Continental Oil

NORTH

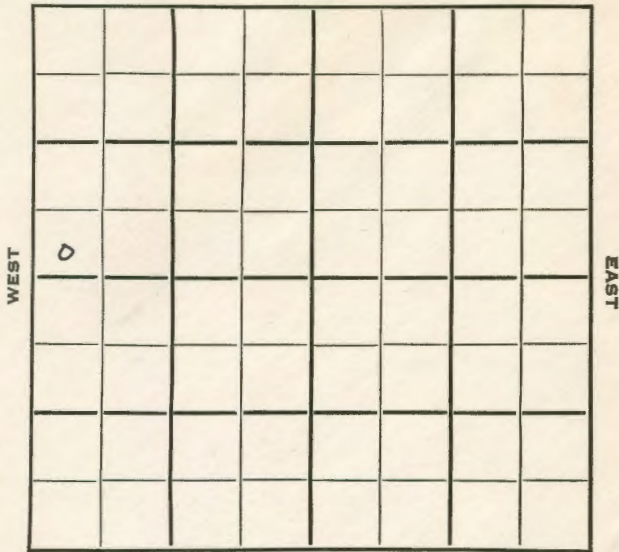

SOUTH

M.

Sec. 23 Twp. 13 R. 8EWell No. #1 Falk FarmContinental Oil CompanyContinental Contractor
Wildcat

Ft. from N. Line


330 Ft. from S. Line

Ft. from E. Line

330 Ft. from W. Line

SW SWNW

NORTH

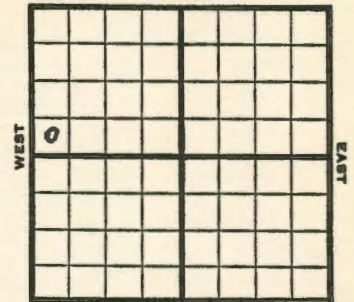

SOUTH

1953 Elev. 1497' REPORT

1/14 RUR

1/28 Spud 1-14-53

D&A

TD 2400

Lans 1430, KC 1526

DST 1645-55, opn 1½ hrs., rec.

8' mud, 60' slaty mud, 60' sw

460#

B KC 1736, Hunton 1937, Maq

2078, Viola 2163, Simp 2277,

Arb. 2357

TD 2400

D&A

ABANDONED

1736
1997

239

1937
1736
201

County	Waubesaunsee			State	Kansas
Sec.	23	(Blk. Twp.)	13	(Sur. Rge.)	8E Map No.
Operator	Continental Oil				
Well No.	1	Farm	Falk		
Elev.	1497	Location	SW SW NW		

[illegible]

Orig. Data	D & A	TD 2400
------------	-------	---------

Lans. 1430	KC 1526	DST 1645-55
open 1½ hr.	Rec. 8' mud	60' salty mud
60' sw 460#	B KC 1736	Hunton 1937
Maq. 2078	Viola 2163	Simp. 2277
Arb. 2357	TD 2400	

D & A

J. B. McGEHEE

County	Hauhaunsee		State	Kansas	
Sec.	23	(Blk.) (Twp.)	13	(Sur.) (Rge.)	8E Map No.
Operator	Continental Oil				
Well No.	1	Farm	Falk		
Elev.	Location		SW 34NW		

[illegible]

Deja Data Wildcat

RUR

1981 12 18

J. G. McGEHEE