


Map No. KANSAS Sec. 27 Twp. 13 R. 8EWell No. 1 Fletcher FarmLedorunis Company

NORTH

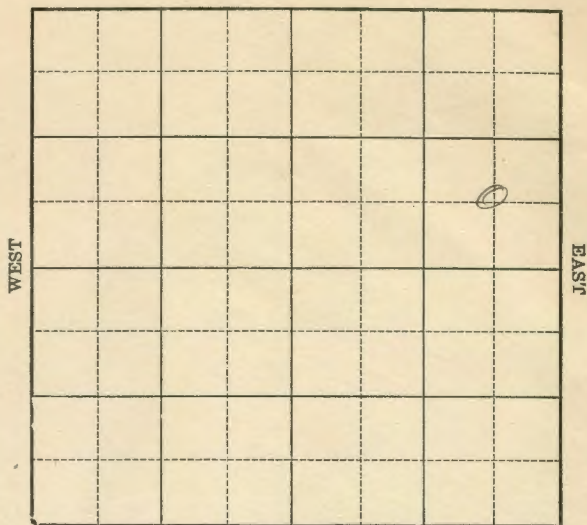

SOUTH

Location
Drilling RemarksRig Up
Drilling Remarks

RECORD

Cased in. ft.

Sand

Gas

Oil

Total Depth

PRODUCTION

1st 24 hrs. Nat.

1st 24 hrs. after shot

Gas cu. ft.


Dry Hole

Abandoned

KANSAS

Map No. Sec. 27 Twp. 13 R. 8EWell No. 1-Fletcher FarmLedorunis Company

NORTH

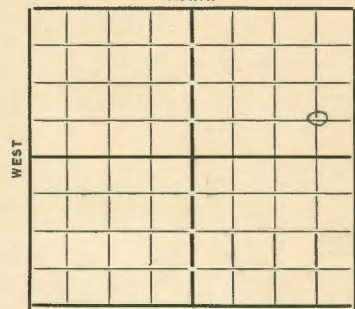

SOUTH

Ft. from N. Line

660 Ft. from S. Line660 Ft. from E. Line

Ft. from W. Line

Date
1933

REPORT

7/12 Show oil 950
T.D. 967 shot no test7/187/268/28/98/98/168/238/309/69/139/209/2910/510/1110/1810/25D. + A. 967

ABANDONED

Map No. 100 Sec. 27 Twp. 13 R. 8EWell No. 1- FletcherLedorunis Company

Contractor

SECTION PLAT

			0

Ft. from N. Line

660 Ft. from S. Line660 Ft. from E. Line

Ft. from W. Line

ABANDONED

Location

Rig up

Drilling and Remarks:

RECORD

Cased in, ft.

Sand

Gas

Oil

Total Depth 967

PRODUCTION

1st 24 hrs. Nat.

1st 24 hrs. after shot

Gas Cu. Ft.

Dry Hole

Abandoned

Date

10-25-33 192 O. Mammuch ScoutMap No. 100 Sec. 27 Twp. 13 R. 8EWell No. 1- FletcherLedorunis Company

Contractor

SECTION PLAT

			0

Ft. from N. Line

660 Ft. from S. Line660 Ft. from E. Line

Ft. from W. Line

FIRST REPORTS

Location

Rig up

Drilling and Remarks:

Show oil 950
TD 967 shot
no test

RECORD

Cased in, ft.

Sand

Gas

Oil

Total Depth

PRODUCTION

1st 24 hrs. Nat.

1st 24 hrs. after shot

Gas Cu. Ft.

Dry Hole

Abandoned

Date

7/12/33 192 Oval Mammuch Scout