


Waubaunsee

KANSAS

Section 13 Township 13 Range 9E

Well No. #1 Munzer

Company Wood Oil & Gas Co.

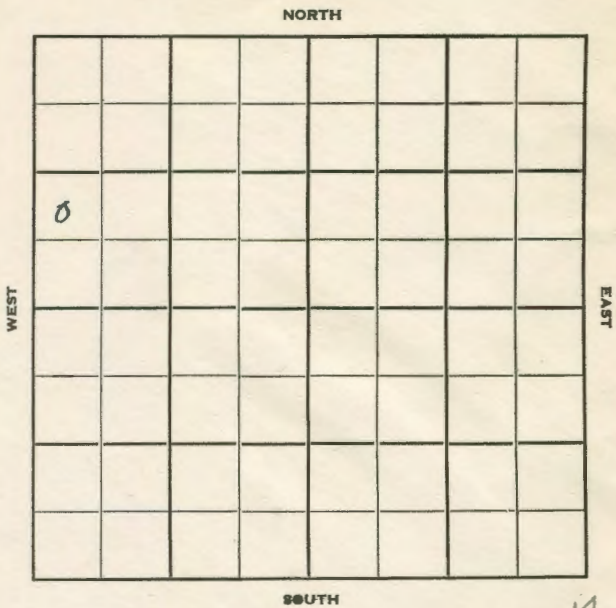

Waubaunsee

KANSAS

Sec. 13 Twp. 13 R. 9E

Well No. #1 Munzer Farm _____

Wood Oil & Gas Co. Company _____

Wood - Contr. Contractor _____


Wildcat

_____ Ft. from N. Line

990' Ft. from S. Line

_____ Ft. from E. Line

330' Ft. from W. Line

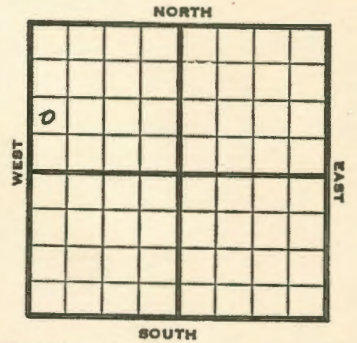

NW SW NW

1951

Elev. 1301' REPORT

5/23

Location

6/27

Spud 6-5-51
 D&A TD 3436
 8" @ 193
 Howard 870
 Heeb. 1245
 KC 1658
 BKC 1853
 Miss 2474
 Hunton 2929 ✓
 Viola 3218
 St. Peter 3342
 TD 3436
 D&A

Top 930
 Lans. 1504
 SO 1828-32
 Burgess 2459
 Kh 2740
 Maq. 3137
 Decora 3319
 Arb. 3406

ABANDONED

$$\begin{array}{r} 1301 \\ 930 \\ \hline +371 \end{array}$$

$$\begin{array}{r} 1504 \\ 1301 \\ \hline -203 \end{array}$$

$$\begin{array}{r} 2474 \\ 930 \\ \hline 1544 \end{array}$$

County Waubaussee State Kansas
 Sec. 13 (Blk. Twp.) 13 (Sur. Rge.) 9E Map No.
 Operator Wood Oil & Gas
 Well No. 1 Farm Munzer
 Elev. 1301 Location NW SW NW

990 Ft. From S Line NW
330 Ft. From W Line Quarter
 Ist. Report
 Completion JUN 27 1951
 Remarks Wildcat
Wood - Contr.
 Spudding Date 6-5-61

Drig. Data D & A TD 3436
8" @ 193 Howard 870 Top. 950
Heeb. 1245 Lans. 1504 KC 1658
SO 1828-32 B KC 1853 Burgess 2459
Miss 2474 Kh 2740 Hunton 2929
Maq. 3137 Viola 3218 Decora 3319
St. Peter 3342 Arb. 3406 TD 3436
D & A

J. E. TYRA

County Waubaussee State Kansas
 Sec. 13 (Blk. Twp.) 13 (Sur. Rge.) 9E Map No.
 Operator Wood Oil & Gas Co.
 Well No. 1 Farm Munzer
 Elev. Location NW SW NW

990 Ft. From S Line NW
330 Ft. From W Line Quarter
 Ist. Report MAY 23 1951
 Completion
 Remarks Carter farmout & DHM
Wood - Contr.
 Spudding Date

Drig. Data Wildcat
Location

J. E. TYRA