

STATE CORPORATION COMMISSION OF KANSAS
OIL & GAS CONSERVATION DIVISION
WELL COMPLETION OR RECOMPLETION FORM
ACO-1 WELL HISTORY
DESCRIPTION OF WELL AND LEASE

Operator: License # 5120
Name Range Oil Company, Inc.
Address 240 Page Court
220 West Douglas
City/State/Zip Wichita, Kansas 67202

Purchaser None

Operator Contact Person John Washburn
Phone (316) 265-6231

Contractor: License # 5124
Name Range Drilling Co.

Wellsite Geologist Bob Olsen
Phone (316) 265-6231

Designate Type of Completion

☒ New Well ☐ Re-Entry ☐ Workover
☐ Oil ☐ SWD ☐ Temp Abd
☐ Gas ☐ Inj ☐ Delayed Comp.
☒ Dry ☐ Other (Core, Water Supply etc.)

If CWFO: old well info as follows:

Operator
Well Name
Comp. Date Old Total Depth

WELL HISTORY

Drilling Method:

☒ Mud Rotary ☐ Air Rotary ☐ Cable

4-28-86 5-7-86 5-7-86
Spud Date Date Reached TD Completion Date

2567 None
Total Depth PBD

Amount of Surface Pipe Set and Cemented at 210 feet
Multiple Stage Cementing Collar Used? Yes ☒ No
If yes, show depth set feet
If alternate 2 completion, cement circulated
from feet depth to w/ SX cmt
Cement Company Name
Invoice #

API NO. 15-041-20,111

County Dickinson

1300' FNL, 1500' FWL, NW
Sec. 31 Twp. 14S Rge. 1 East

3980 Ft North from Southeast Corner of Section

3780 Ft West from Southeast Corner of Section

(Note: Locate well in section plat below)


Lease Name Miller "F" Well # 1

Field Name Wildcat (Bonnacord Abd.)

Producing Formation None

Elevation: Ground 1243 KB 1248

Section Plat

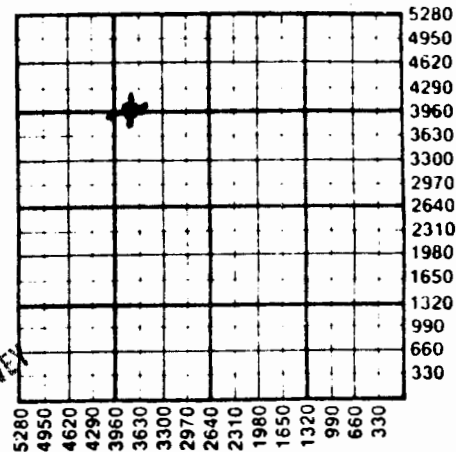

MAY 20 1986

WATER SUPPLY INFORMATION

Disposition of Produced Water: Disposal
Docket # NA Repressuring

Questions on this portion of the ACO-1 call:

Water Resources Board (913) 296-3717

Source of Water:

Division of Water Resources Permit #

Groundwater Ft North from Southeast Corner
(Well) Ft West from Southeast Corner of
Sec Twp Rge East West

Surface Water Ft North from Southeast Corner
(Stream, pond etc) Ft West from Southeast Corner
Sec Twp Rge East West

Other (explain)
(purchased from city, R.W.D. #)

INSTRUCTIONS: This form shall be completed in duplicate and filed with the Kansas Corporation Commission, 200 Colorado Derby Building, Wichita, Kansas 67202, within 90 days after completion or recompletion of any well. Rule 82-3-130 and 82-3-107 apply.

Information on side two of this form will be held confidential for a period of 12 months if requested in writing and submitted with the form. See rule 82-3-107 for confidentiality in excess of 12 months.

One copy of all wireline logs and drillers time log shall be attached with this form. Submit CP-4 form with all plugged wells. Submit CP-111 form with all temporarily abandoned wells.

31-41-16

SIDE TWO

Operator Name Range Oil Company, Inc. Lease Name Miller "F" Well # 1

Sec. 31 Twp. 14S Rge. 1 East West County Dickinson

WELL LOG

INSTRUCTIONS: Show important tops and base of formations penetrated. Detail all cores. Report all drill stem tests giving interval tested, time tool open and closed, flowing and shut-in pressures, whether shut-in pressure reached static level, hydrostatic pressures, bottom hole temperature, fluid recovery, and flow rates if gas to surface during test. Attach extra sheet if more space is needed. Attach copy of log.

Drill Stem Tests Taken Yes No
Samples Sent to Geological Survey Yes No
Cores Taken Yes No

Formation Description
Log Sample

DST (1) 2492-2507 30-30-30-45 Blow: died in 10"
Rec: None IFP 20-20 ISIP 20 FFP 20-20
FSIP 20 T:99°F.

DST (2) 2508-2516 30-30-30-45 Blow: wk Rec: 80'
MSW IFP 40-50 ISIP 690 FFP 81-81
FSIP 690 T:100°F.

Name	Top	DATUM
Brn Ls.	1824	- 576
Lans	1868	- 620
BKC	2236	- 988
Ck	2395	-1147
Bg zn	2501	-1253
Mdol	2510	-1262
M. Os	2562	-1314
RTD	2567	-1319

CASING RECORD ☒ New ☐ Used							
Report all strings set-conductor, surface, intermediate, production, etc.							
Purpose of String	Size Hole Drilled	Size Casing Set (In O.D.)	Weight Lbs/Ft.	Setting Depth	Type of Cement	#Sacks Used	Type and Percent Additives
Surface	12.25	8.625	23	210	Common	150	3% CaCl
PERFORATION RECORD				Acid, Fracture, Shot, Cement Squeeze Record			
Shots Per Foot	Specify Footage of Each Interval Perforated			(Amount and Kind of Material Used)			Depth
TUBING RECORD							
Size	Set At	Packer at	Liner Run	☐ Yes ☒ No			