

Map No. KANSAS Sec. 12 Twp. 14 R. 1EWell No. 1 EngleMarlough & Co. Company

Contractor

SECTION PLAT

		0	

980 Ft. from N. Line

Ft. from S. Line

Ft. from E. Line

980 Ft. from W. Line

FIRST REPORTS

Location

Rig up

Drilling and Remarks:

Cellar

RECORD

Cased _____ in., _____ ft.

Sand _____

Gas _____

Oil _____

Total Depth _____

PRODUCTION

1st 24 hrs. Nat. _____

1st 24 hrs. after shot _____

Gas _____ Cu. Ft.

Dry Hole _____

Abandoned _____

Date

OCT 31 1926S. J. LEWIS

Scout

Dickerson

MAP No. KANSAS SEC. 12 TWP. 14S R. 1EWell No. 1 EngleMarlough COMPANY

CONTRACTOR

SECTION PLAT

ABANDONED

		0	

Ft. FROM N. LINE

Ft. FROM S. LINE

Ft. FROM E. LINE

Ft. FROM W. LINE

LOCATION

RIG UP

DRILLING AND REMARKS:

no wall
map

RECORD

CASED _____ IN. _____ FT.

SAND _____

GAS _____

OIL _____

TOTAL DEPTH 3456

PRODUCTION

1ST 24 HRS. NAT. _____

1ST 24 HRS. AFTER SHOT _____

GAS _____ Cu. Ft.

DRY HOLE ✓ABANDONED ✓

DATE

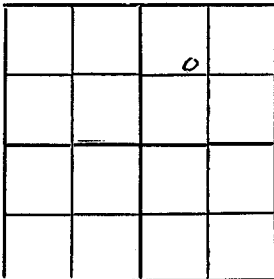
3/9 1926

SCOUT

Map No. KANSAS Sec. 12 Twp. 14 R. 1EWell No. 1 EngleMarland et al Company

Contractor

SECTION PLAT

980 Ft. from N. Line

Ft. from S. Line

Ft. from E. Line

980 Ft. from W. Line**ABANDONED**

Location

Rig up

Drilling and Remarks:

TD 3650I & A.

RECORD

Cased _____ in., _____ ft.

Sand _____

Gas _____

Oil _____

Total Depth _____

PRODUCTION

1st 24 hrs. Nat. _____

1st 24 hrs. after shot _____

Gas _____ Cu. Ft.

Dry Hole _____

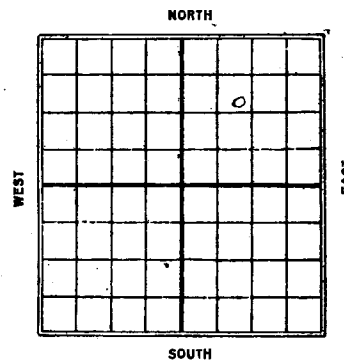
Abandoned _____

Date

MAR 9 1936 S. J. LEWIS ScoutMap No. Kansas Sec. 12 Twp. 14 R. 1EWell No. 1 Engle FarmMarland et al Company980 Ft. from N. Line

Ft. from S. Line

Ft. from E. Line

980 Ft. from W. Line

Date

1925

REPORT

10/21Cellar10/28R.O. G.19263/9Abandoned 3650

NORTH

TEST

LAST

SOUTH

Drilling Remarks

Drilling Remarks

RECORD

Cased_____in. _____ft.

Sand

Gas

Oil

Total Depth

PRODUCTION

1st 24 hrs. Nat. _____

1st 24 hrs. after shot _____

Gas _____ cu. ft.

Dry Hole.

Abandoned