


Drewson

MAP No. *KANSAS* SEC. *15* TWP. *14S* R. *1E*

WELL No. *1* *Frank*
McClain COMPANY
K CONTRACTOR

SECTION PLAT

ABANDONED

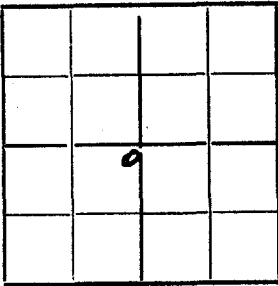


_____ FT. FROM N. LINE
_____ FT. FROM S. LINE
_____ FT. FROM E. LINE
_____ FT. FROM W. LINE

Map No. *KANSAS* Sec. _____ Twp. _____ R. _____

Well No. _____ Farm _____
_____ Company

_____ Ft. from N. Line
_____ Ft. from S. Line
_____ Ft. from E. Line
_____ Ft. from W. Line

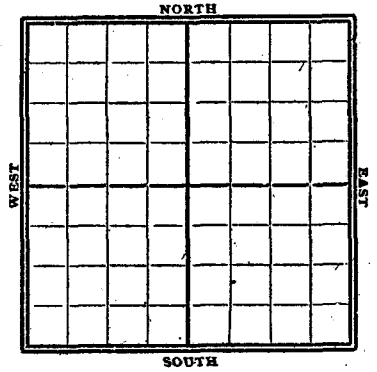

RECORD

LOCATION _____

CASED _____ IN. _____ FT.

RIG UP _____

SAND _____

DRILLING AND REMARKS:

GAS _____

*no wall
mud*

OIL _____

TOTAL DEPTH *5800*

PRODUCTION

1ST 24 HRS. NAT. _____

1ST 24 HRS. AFTER SHOT _____

GAS _____ CU. FT.

DRY HOLE

ABANDONED

DATE *Apr 2* 192*1*

SCOUT

1921

Date

REPORT

4/2 *Abd T.D. 2800*
Gypsy Records

