

No County Map

County **Dickinson** Elev. _____
 Sec. **24** Twp. **14** Rge. **1E**
 Company **D. T. Ingling etal.**
 Farm Name **Bolliger** No. **1**

| TOPS | DEPTH | LOG | DATUM | Loc. in Sec. |
|--------|-------|-----|-------|-----------------|
| Anh. | | | | SE SW SE |
| TP. | | | | |
| H. | | | | |
| Tr. | | | | |
| Dg. | | | | |
| Bl. | | | | |
| L. | | | | Geol. _____ |
| K.C. | | | | Contr. _____ |
| B.K.C. | | | | Co. tools _____ |
| Ce. | | | | |
| C. | | | | Pool _____ |
| M. | | | | |
| M. | | | | Wildcat |
| K. | | | | |
| Mz. | | | | |
| Me. | | | | |
| V. | | | | |
| S. | | | | |
| S. | | | | |
| A. | | | | |
| R. | | | | |
| PE. | | | | |
| G. | | | | |
| TR. | | | | |

FIRST REPORT
 MAY 16 1956

Date Comm. **5-15-56**

Co.
 Sec.
 No.
 Sec.
 T.
 R.

Dickinson KANSAS

SEC. 24 TWP. 14 R. 1E

WELL NO. #1 Bolliger FARM

COMPANY D.T. Ingling etal

CONTRACTOR Co. Tools


WILDCAT

Ft. from N. Line

Ft. from S. Line

Ft. from E. Line

Ft. from W. Line

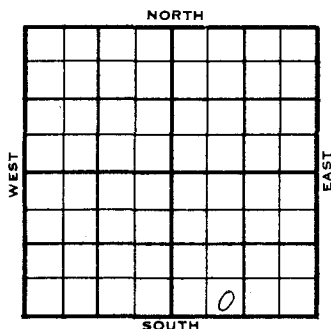

SE SW SE

1956 ELEVATION 1229' REPORT

- 5-16 Comm. 5-15-56
- 5-23 8 5/8" @105
- Drlg. 1940'
- 5-29 No report
- 6-6 RTD 2470'
- no tests
- 6-13 D & A
- 6-20 D & A
- B.L. 1796', L. 1823', B.K.C. 2196',
- M. 2445'
- TD 2470'

ABANDONED

Handwritten calculations:

$$\begin{array}{r} 2196 \\ 1229 \\ \hline 967 \end{array}$$

$$\begin{array}{r} 1923 \\ 1229 \\ \hline -594 \end{array}$$

$$\begin{array}{r} 2445 \\ 1923 \\ \hline 622 \end{array}$$

$$\begin{array}{r} 2196 \\ 1229 \\ \hline -967 \end{array}$$

$$\begin{array}{r} 2445 \\ 2196 \\ \hline 249 \end{array}$$

$$\begin{array}{r} 2445 \\ 2196 \\ \hline 249 \end{array}$$

DX-78

Dickinson KANSAS


15-041-0010)

SECTION 24 TOWNSHIP 14 RANGE 1E

WELL NO. #1 Bolliger

COMPANY D. T. Inglin,etal

NORTH

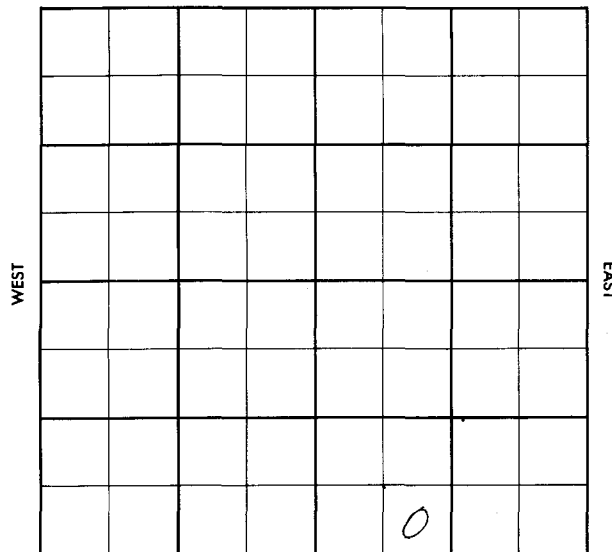

SOUTH