



Dickinson

KANSAS


SEC.	TWP.	R.
29	14	1E

WELL NO. #1 C. Emig FARM

COMPANY F.S. Williams et al

CONTRACTOR Ingling

Wildcat.

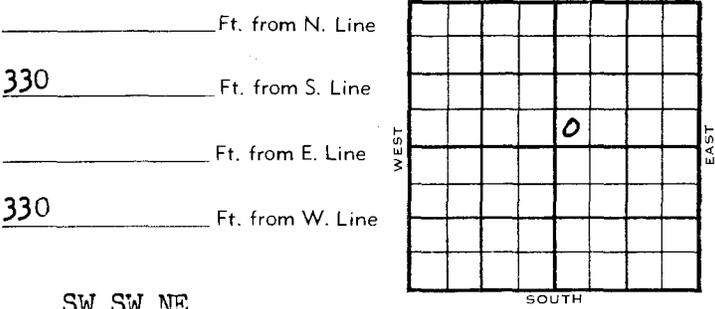

SW SW NE

	ELEVATION	REPORT
1955	1262'	
4/27	Spud 4-22-55 8" @ 95' Drlg. 600'	
5/26	Spud 4-22-55 8" @ 95 w/60 5 1/2" @ 2511 w/25 TD 2528' wtr. PB 2512' 13/2506-10 B/2 BOPH 4 hrs. B/2 BOPH 4 hr. B/2 BOPH 20% hr. Strato-frac. 1000 oil, rec 70 bbl load SI 8 hr. FU 2100' fluid (400' oil & 1700' wtr.) S/2 BOPH 28 BW D & A Tops: Brown lime 1837', Lansing 1865' Burg. 2503', Miss. 2509' TD 2528'	
		<b>ABANDONED</b>

DX-78

15-041-00058

KANSAS

DX 78-1 Dickinson

Section 29 Township 14 Range 1E

Well No. #1 C. Emig

Company F. S. Williams et al

