

Dickinson

KANSAS

SEC.	TWP.	R.
29	14	1E

WELL NO. #1 C. Shirack FARM

COMPANY James R. Craig & DT. Ingling et al

CONTRACTOR Co. Tools.

Wildcat.


Ft. from N. Line

990 Ft. from S. Line

Ft. from E. Line

330 Ft. from W. Line

NW SW SW

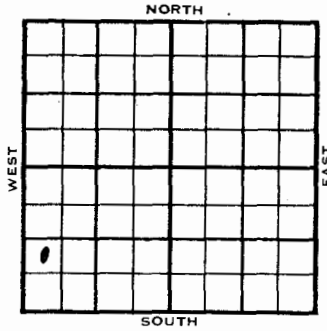


15-041-00059
DX 78-1

Dickinson KANSAS

Section 29 Township 14 Range 1E

Well No. 1 C. Shirack

Company James R. Craig & D. T. Ingling et al

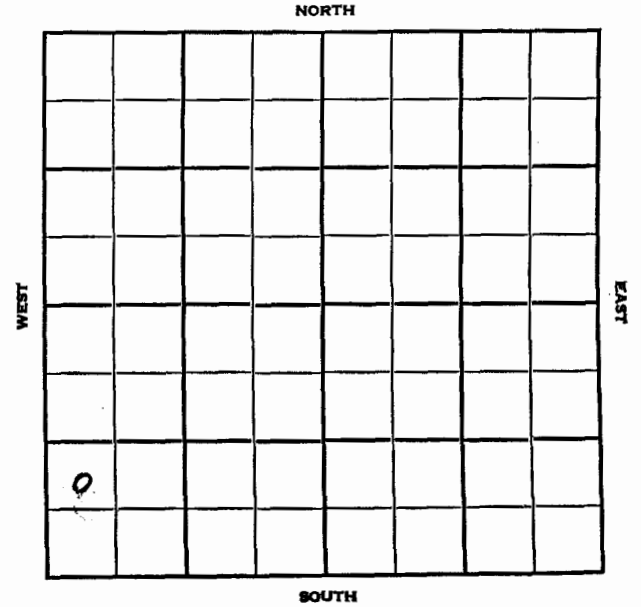

1955	ELEVATION 1244'	REPORT
------	--------------------	--------

1/26 Spud 1-23-55
8" @ 100'
WOC

2/9 Spud 1-23-55
8" @ 100'
Miss 2498'
TD 2521'
D & A

ABANDONED