

OWWO

County Dickinson Elev. 1260
 Sec. 31 Twp. 14 Rge. 1E
 Company Corum & Corswy (was Ingling)
 Farm Name Pettitt (was Shirack) No. 1

TOPS	DEPTH	LOG	DATUM	Loc. in Sec.
Anh.				NW NE NE
Tr.				
H.				
Tr.				
Dg.				
Bl.				
L.				
K.C.				Geol.
B.K.C.				Contr.
Ce.				
C.				
M.				
M.				Pool
K.				Semi Wildcat
Mz.				
Me.				
V.				
S.				
S.				
A.				
R.				
Pe.				
G.				

ABANDONED

Date Comm. JUL 27 1955

Burg. 2503 Miss. 2507 Viola 3144

OTD 3184

Abd.

Co.

Loc.

No.

Sec.

T.

R.

Top. Pool

Co. Facet

FIRST REPORT

County Dickinson Elev. 1260
 Sec. 31 Twp. 14 Rge. 1E
 Company Corum & Corswy (was Ingling)
 Farm Name Pettitt (was Shirack) No. 1

TOPS	DEPTH	LOG	DATUM	Loc. in Sec.
Anh.				NW NE NE
Tr.				O.W.W.O.
H.				OWWO
Tr.				NO RECORD
Dg.				
Bl.				
L.				
K.C.				Geol.
B.K.C.				Contr.
Ce.				
C.				
M.				
M.				Pool
K.				Semi-Wildcat
Mz.				
Me.				
V.				
S.				
S.				
A.				
R.				
Pe.				
G.				

Date Comm. 5-25-55

Burg. 2503 Miss. 2507 Viola 3144

OTD 3184 to wash down, log & run eng.

Co.

Loc.

No.

Sec.

T.

R.

O.W.W.O.

FORM 513 REV. SUNRAY

OWWO

County **Dickinson** Elev. **1220**Sec. **31** Twp. **14** Rge. **1E**Company **Corum & Crosey**FarmName **Pettit** No. **1**

TOPS	DEPTH	LOG	DATUM	Loc. in Sec.
Anh.				NW NE NE
TP.				
H.				
Tr.				
Dg.				
Bl.				
L.				Geol.
K.C.				Contr.
B.K.C.				
Ce.				
C. <i>Burgess</i>	<i>2503</i>			Ingling
M.	<i>2507</i>			
K.				
Mz.				
Mo.				
V.	<i>3144</i>			
S.				
S.				
A.				
R.				
PE.				
G.				
TD	<i>3184</i>			

AUG 10 1955
FIRST REPORT

Date Comm.

OTD 3184 to CO & set pipe

FORM 513 REV. SUNRAY

OWWO

County **Dickinson** Elev. **1220**Sec. **31** Twp. **14** Rge. **1E**Company **Corum & Crosey**FarmName **Pettit** No. **1**

TOPS	DEPTH	LOG	DATUM	Loc. in Sec.
Anh.				NW NE NE
TP.				
H.				
Tr.				
Dg.				
Bl.				
L.				Geol.
K.C.				Contr.
B.K.C.				
Ce.				
C. <i>Burgess</i>	<i>2503</i>		<i>1283</i>	Ingling
M.	<i>2507</i>		<i>1287</i>	
K.				
Mz.				
Mo.				
V.	<i>3144</i>		<i>1924</i>	
S.				
S.				
A.				
R.				
PE.				
G.				
TD	<i>3184</i>			

ABANDONED

Date Comm.

AUG 24 1955**OTD 3184 CO to 2620 4 1/2" @ 2566****CO to 2535 16/ 2524-29 VSSO****500 A HFW****D & A**

Sec. 31 Twp. 14 R. 1E

Well No. #1 ~~Schirak~~ ^{Pettit} Farm


Conan & Crosby
Don Ingling Company
Bonaccord (Ingling-Cona)

330 Ft. from N. Line

Ft. from S. Line

990 Ft. from E. Line

Ft. from W. Line

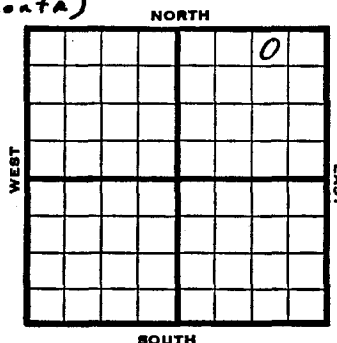

NW NE NE

REPORT	
1945	1220' Elev. 1260
10/31	8" @ 87 Drlg. 305
11/7	Drlg. 2410'
11/14	Burgess 2503 Miss. 2507 Viola 3144 Drlg. 3147'
11/21	Hunton 2863 TD 3134
ABANDONED	
1955	O.W.W.O.
8/10	OTD 3184' To CO & set pipe. Burgess 2503', Miss 2507', Viola 3144' TD 3184'
8-24	OTD 3184 Co to 2620 4 1/2" @ 2566, Co to 2535 16/ 2524-29 VSSO 500 A HFW D & A C. Burgess 2503, 1283, M. 2507, 1287, V. 3144, 1924, T.D. 3184
ABANDONED	

2963
2507
356

NO-RECORD Dickinson KANSAS

SEC. 31 TWP. 14 R. 1 E
 WELL NO. # 1 Pettitt (Was Shirack) FARM
 COMPANY Corum & Corswy (Was Ingling)
 CONTRACTOR

Semi-Wildcat


Ft. from N. Line

Ft. from S. Line

Ft. from E. Line

Ft. from W. Line

NW NE NE

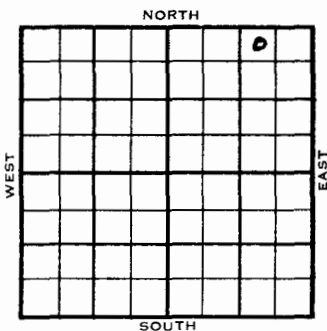

1955

ELEVATION

1260'

REPORT

O.W.W.O. NO-RECORD

5/25

Burg 2503' Miss 2507' Viola 3144'
 OTD 3184' To wash down, log & run csg.

7/27

ABD.

ABANDONED

DX-78

O.W.W.O. NO-RECORD

Section 31 Township 14 Range 1 E
 Dickinson KANSAS
 Well No. #1 Pettitt (was Shirack)
 Company Corum & Corswy (was Ingling)

