

S-513-B

County Dickinson Elev. _____

Sec. 31 Twp. 14S Rge. 1E

Company H. S. Currier

Farm Name Pettit No. 1

TOPS	DEPTH	LOG	DATUM	Loc. in Sec.
Anh.				E₁ NE NE
Tp.				DS - NE₁ NE₁
H.				
Tr.				
Dg.				
B.L.				
L.				
K.C.				Geol. _____
B.K.C.				Contr. _____
Ce.				Greenland
C.				#1
M.				Pool _____
K.				Bormacord
Mz.				
Mq.				
V.				
S.				
S.				
A.				
R.				
Pf.				
G.				
T.D.				

Date Comm. _____

MIRT

S-513-B

County Dickinson Elev. _____

Sec. 31 Twp. 14S Rge. 1E

Company H. S. Currier Tom Brown

Farm Name Pettit No. 1

TOPS	DEPTH	LOG	DATUM	Loc. in Sec.
Anh.				E₁ NE NE
Tp.				DS - NE₁ NE₁
H.				
Tr.				
Dg.				
B.L.				
L.		1881		Geol. _____
K.C.				Contr. _____
B.K.C.				Greenland
Ce.				#1
C.		2524		Pool _____
M.				Bormacord
M.				
K.				
Mz.				
Mq.				
V.				
S.				
S.				
A.				
R.				
Pf.				
G.				
T.D.		2539		

Date Comm. **8-11-58** **8" 130**

MIRT **AUG 20 58** **in Burgess sd**

ABANDONED

D to A

CORRECTION

Dickinson


15-041-00138

SECTION 31 TOWNSHIP 14S RANGE 1E

WELL NO. #1 Pettib Elev 1253' L&S.

COMPANY H.S. Carrier Tom Brown

NORTH E/2 NE NE

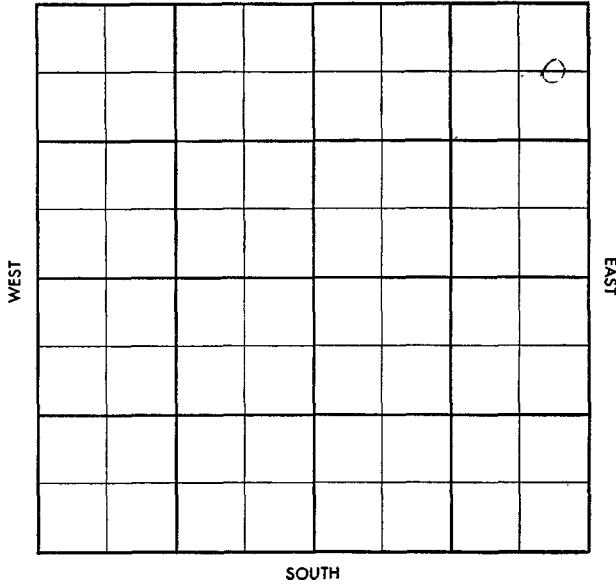

1253