

Dickinson KANSAS

SEC. 31 TWP. 14 R. 1E

WELL NO. 1 Pettit FARM

COMPANY Leben Drlg.

CONTRACTOR Musgrove Wildcat


330 Ft. from N. Line

Ft. from S. Line

330 Ft. from E. Line

Ft. from W. Line

NE NE NE

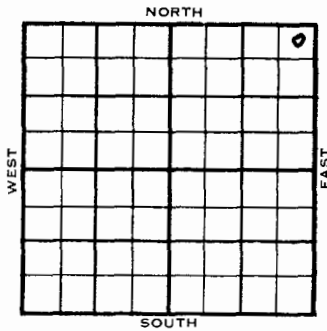

Dickinson

DX 78-1


15-041-00024

KANSAS

Section 31 Township 14 Range 1E

Well No. #1 Pettit

Company Leben Drlg.

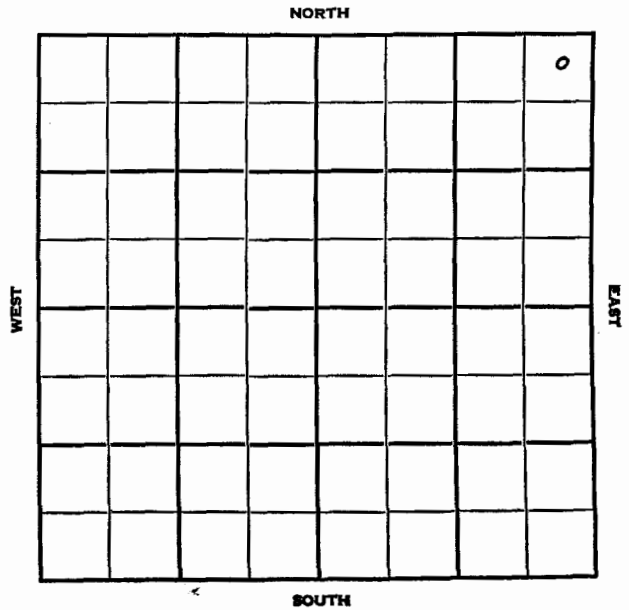

1954	ELEVATION 1253'	REPORT
11/23	Spud 11-18-54 8" @ 82' Drlg. 1975'	
12/22	Spud 11-18-54 Oil Well TD 2516' 8" @ 82' Br. Lime 1838' Lans 1879' BKC 2040' Burgess 2509' Miss 2511' DST 2507'-15' opn 1/2 hr, rec 4' Mud 745# TD 2515' 5" @ 2513' CO to 2515' DD 2516' 1 go 12 hr. 400 A Wtr. 12/ 2510-13 1000 A 4 bo 126 bw. 24 hr. re-perf 2510-13 4 bo 126 bw. 24 hr. Comp.	COMPLETED