

County Dickinson Elev. \_\_\_\_\_  
 Sec. 31 Twp. 14S Rge. 1E  
 Company D. T. Ingling  
 Farm Name Kogler No. 1

TOPS	DEPTH	LOG	DATUM	Loc. in Sec.
Anh.				SW SE SE
TP.				
H.				
Tr.				
Dg.				
Bl.				
L.				Geol.
K.C.				Contr.
B.K.C.				
Ce.				
C.				
M.				Pool
M.				Semi W.C.
K.				
Mz.				
Me.				
V.				
S.				
S.				
A.				
R.				
Pe.				
G.				
TD				

FIRST REPORT  
 JUL 25 1956  
 0

Date Comm. \_\_\_\_\_  
MIRT

FORM 515 SUNRAY No County Map

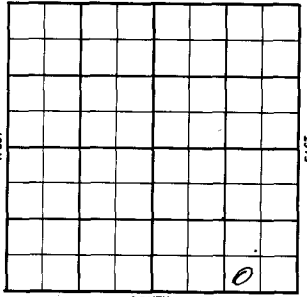
County Dickinson Elev. 1297  
 Sec. 31 Twp. 14S Rge. 1E  
 Company D. T. Ingling  
 Farm Name Kogler No. 1

TOPS	DEPTH	LOG	DATUM	Loc. in Sec.
Anh.				SW SE SE
TP.				
H.				
Tr.				
Dg.				
Bl.				
L.				Geol.
K.C.				Contr.
B.K.C.				
Ce.				
C.				
M.	<u>2572</u>			Pool
M.				Semi W.C.
K.				
Mz.				
Me.				
V.				
S.				
S.				
A.				
R.				
Pe.				
G.				
TD	<u>2602</u>			

ABANDONED  
 0

Date Comm. AUG 8 '56  
MIRT. REC. 1-56 7-26-56 2578  
90 IP 1250 AUG 8 '56  
DEA

Dickinson KANSAS  
 SEC. 31 TWP. 14S R. 1E  
 WELL NO. #1 Kogler FARM  
 COMPANY D.T. Ingling  
 CONTRACTOR

Semi-Wildcat  
 \_\_\_\_\_ FT. FROM N. LINE  
 \_\_\_\_\_ FT. FROM S. LINE  
 \_\_\_\_\_ FT. FROM E. LINE  
 \_\_\_\_\_ FT. FROM W. LINE  
 SW SE SE  


1956 ELEVATION 1297' REPORT

7-25 MIRT  
 8-8 Comm. 7-26-56  
 8 5/8" @ 90  
 D & A ^  
 M. 2572';  
 TD 2602'

ABANDONED

15-041-00108  
 DX 78-1 Dickinson KANSAS  
 Section 31 Township 14S Range 1E  
 Well No. 1 Kogler  
 Company D. T. Ingling

