

Dickinson

KANSAS Map No. 50 Sec. 34 Twp. 14 R. 1E

Well No. 1 Seedergreen

Auto Ordnance Company

FIRST REPORT Contractor

NE SE SE


SECTION PLAT

Ft. from N. Line

990 Ft. from S. Line

300 Ft. from E. Line

Ft. from W. Line

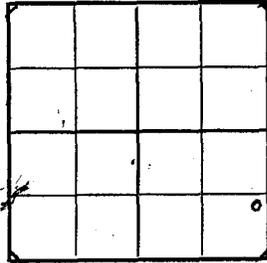

WILDCAT

Location XXX

RECORD

Cased in, ft.

Sand

Gas

Oil

Total Depth

PRODUCTION

1st 24 hrs. Nat.

1st 24 hrs. after shot

Gas Cu. Ft.

Dry Hole

Abandoned

Date

JUL 7 1943 19 S. J. LEWIS Scout

Dickinson

KANSAS Map No. 50 Sec. 34 Twp. 14 R. 1E

Well No. 1 Seedergreen

Auto Ordnance Company

ABANDONED Contractor

NE SE SE


SECTION PLAT

Ft. from N. Line

990 Ft. from S. Line

330 Ft. from E. Line

Ft. from W. Line

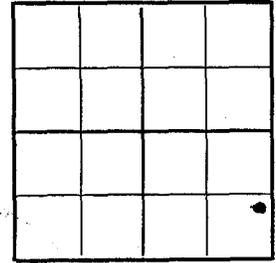

WILDCAT

Location

RECORD

Cased in, ft.

Sand

Gas

Oil

Total Depth 2476

PRODUCTION

1st 24 hrs. Nat.

1st 24 hrs. after shot

Gas Cu. Ft.

Dry Hole

Abandoned

Date

JUL 2 8 1943 19 S. J. LEWIS Scout

KANSAS

Dickinson

Sec. 34 Twp. 14 R. 1-E

Well No. #1 Seedergreen Farm _____

Auto Ordnance Company _____

Wildcat


_____ Ft. from N. Line

990 Ft. from S. Line

330 Ft. from E. Line

_____ Ft. from W. Line

Elv. 1214

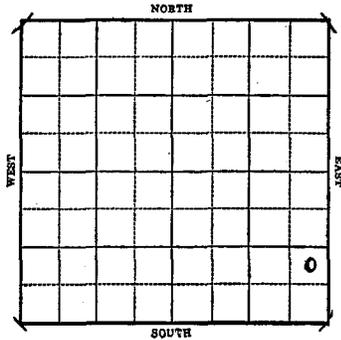

REPORT

1943

- 7/7 Location.
- 7/15 8" @ 91&
.T.D. 188'
- 7/21 WOC.
Lans 1790'
Drlg. 2125'
- 7/28 Miss. 2438'
T.D. 2476'

ABANDONED

Lans - 576	2438	1790
M - 1224	<u>1214</u>	<u>1214</u>
L-m 648	1224	576
	576	
	648	

Dickinson

Section 34 Township 14 Range 1-E

Well No. #1 Seedergreen

Company Auto Ordnance

