

County	Waubaunsee			State	Kansas
Sec.	3	(Blk. Twp.)	14	(Sur. Rge.)	10E Map No.
Operator	E. Wakefield etal.				
Well No.	1	Farm	A. P. Miller		
Elev.		Location	SE SW NW		
			330 Ft. From	S Line	NW
			990 Ft. From	W Line	Quarter
			1st. Report SEP 12 1950		
			Completion		
			Remarks		
			Carter farmout		
			Spudding Date		
Drig. Data	Davis Ranch Pool				

Location

J. E. TYRA

County	Waubaunsee			State	Kansas
Sec.	3	(Blk. Twp.)	14	(Sur. Rge.)	10E Map No.
Operator	E. Wakefield etal.				
Well No.	1	Farm	A. P. Miller		
Elev.	1284	Location	SE SW NW		
			330 Ft. From	S Line	NW
			990 Ft. From	W Line	Quarter
			1st. Report		
			Completion OCT 11 1950		
			Remarks Davis Ranch Pool		
			Spudding Date 9-25-50		
Drig. Data	D & A TD 3210				

8" @ 128 Lans. 1456 KC 1602 B KC 1815
 Miss 2460 Kinderhook 2800 Hunton 2985
 Maq. 3127 Viola 3205 TD 3210
 D & A

J. E. TYRA

Waubaunsee

KANSAS

Sec. 3 Twp. 14 R. 10E

Well No. #1 A. P. Miller Farm

E. Wakefield et al Company

Davis Ranch Pool Contractor


Ft. from N. Line

330' Ft. from S. Line

Ft. from E. Line

990' Ft. from W. Line

SE SW NW

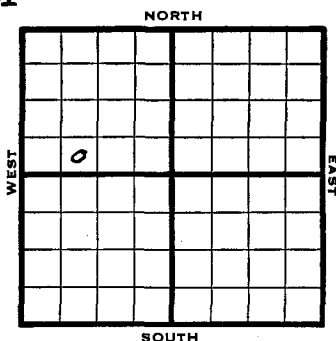

1950 Elev. 1284' REPORT

9/13 Location

10/11 Spud 9-25-50
D&A TD 3210
8" @ 128 Lans. 1456'
KC 1602' BKC 1815'
Miss 2460 Kinderhook 2800
Hunton 2985 Maq. 3127'
Viola 3205' TD 3210
D&A
ABANDONED

2985
2460
525

15-197-00095

FORM 51 25M 3-49 PETROL

Waubaunsee

KANSAS

Section 3 Township 14 Range 10E

Well No. #1 A. P. Miller

Company E. Wakefield et al

