

Map No. _____ Sec. 4 Twp. 14 R. 10EWell No. 5 Davis "B"

Carter _____ Company

Contractor

SW NE NE

FIRST REPORT
SECTION PLAT990 Ft. from N. Line

_____ Ft. from S. Line

990 Ft. from E. Line

_____ Ft. from W. Line

Wabaunsee County

Location X

RECORD

Cased _____ in., _____ ft.

Sand _____

Gas _____

Oil _____

Total Depth _____

PRODUCTION

1st 24 hrs. Nat. _____

1st 24 hrs. after shot _____

Gas _____ Cu. Ft.

Dry Hole _____

Abandoned _____

Date

DEC 7 1949 S. J. LEWIS ScoutMap No. _____ Sec. 4 Twp. 14 R. 10EWell No. 5 Davis "B"

Carter _____ Company

Contractor

SW NE NE

SECTION PLAT

990 Ft. from N. Line

_____ Ft. from S. Line

990 Ft. from E. Line

_____ Ft. from W. Line

Wabaunsee County

Location _____

RECORD

Cased _____ in., _____ ft.

Sand _____

Gas _____

Oil _____

Total Depth 3306

PRODUCTION

1st 24 hrs. Nat. _____

1st 24 hrs. after shot _____

Gas _____ Cu. Ft.

Dry Hole _____

Abandoned _____

Drilling and Remarks:

10" @ 180
Howard 855
Jopoka 917
Heb. 1230
Rane. 1508
K.C. 1655
B.K.C. 1870
Miss. 2477
Kind. 2786Hinton 3046May. 3201Date Viola 328210 + 4JAN 4 1950

19

J. E. Lynn Scout

Wabaunsee KANSAS

Sec. 4 Twp. 14 R. 10E

Well No. #5 Davis "B" Farm

Carter

Company

Davis Ranch Pool


990' Ft. from N. Line

Ft. from S. Line

990' Ft. from E. Line

Ft. from W. Line

SW NE NE

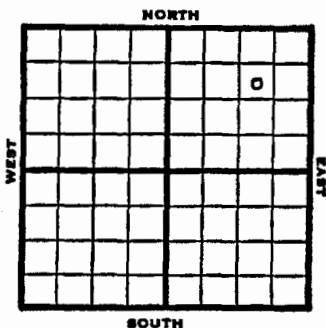

1950

O.W.W.O.

8/8 OTD 3306' Hunton 3045'
Maq 3205' Viola 3282'
CO to 3306
7" @ 3283'
180/3114-44 40000 A
Took 182 BW 30 min
5" @ 3093'
Comp. for SWD

FIRST REPORT
COMPLETED

1949 REPORT

12/7 Location
12/14 RUR
12/21 10" @ 180'
KC 1655'
Drlg 2390'
12/28 Miss 2477'
drlg 2775'
1950
1/4 TD 3306'
10" @ 180'
Howard 855'
Topeka 917'
Heeb 1230'
Lans 1508'
KC 1655'
B&O 1870'
Miss 2477'
King 2786'
Hunton 3046'
Maq 3201'
Viola 3282'
D&A
Aband.

3046
2477
562

ABANDONED

OVER

Section 4 Township 14 Range 10E

Well No. #5 Davis "B"

Company Carter

Davis Ranch Pool NORTH O.V.W.O.

