

Wabaunsee KANSAS

Sec. 4 Twp. 14 R. 10E

Well No. #5 Davis "B" Farm _____
Carter Company


Davis Ranch Pool

990' Ft. from N. Line

_____ Ft. from S. Line

990' Ft. from E. Line

_____ Ft. from W. Line
SW NE NE

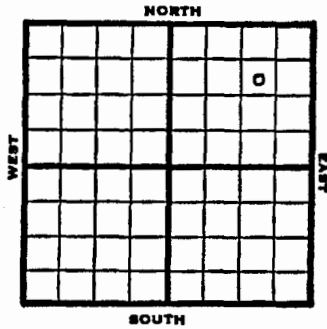

1950

O.W.W.O.

8/8 OTD 3306' Hunton 3045'
Maq 3205' Viola 3282'
CO to 3306
7" @ 3283'
180/3114-44 40000 A
Took 182 BW 30 min
5" @ 3093'
Comp. for SWD

FIRST REPORT
COMPLETED

3046
2477
3282

1949	REPORT
12/7	Location
12/14	RUR
12/21	10" @ 180' KC 1655' Drlg 2390'
12/28	Miss 2477' drlg 2775'
1950 1/4	TD 3306' 10" @ 180' Howard 855' Topeka 917' Heeb 1230' Lans 1508' KC 1655' B&O 1870' Miss 2477' King 2786' Hunton 3046' Maq 3201' Viola 3282' D&A Aband.
	ABANDONED
	OVER

