

Kansas

Davis Ranch Pool

Map No. \_\_\_\_\_ Sec. 4 Twp. 14 R. 10EWell No. 3 Davis "B"

Carter \_\_\_\_\_ Company

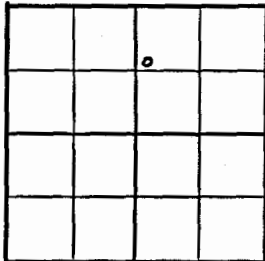
Contractor

SW NW NE

FIRST REPORT  
SECTION PLAT990 Ft. from N. Line

\_\_\_\_\_ Ft. from S. Line

\_\_\_\_\_ Ft. from E. Line

330 Ft. from W. Line

Wabaunsee County

Location X

## RECORD

Cased \_\_\_\_\_ in., \_\_\_\_\_ ft.

Sand \_\_\_\_\_

Gas \_\_\_\_\_

Oil \_\_\_\_\_

Total Depth \_\_\_\_\_

## PRODUCTION

1st 24 hrs. Nat. \_\_\_\_\_

1st 24 hrs. after shot \_\_\_\_\_

Gas \_\_\_\_\_ Cu. Ft.

Dry Hole \_\_\_\_\_

Abandoned \_\_\_\_\_

Date

OCT 12 1949

19

S. J. LEWIS

Scout

Kansas

Davis Ranch Pool

Map No. \_\_\_\_\_ Sec. 4 Twp. 14 R. 10EWell No. 3 Davis "B"

Carter \_\_\_\_\_ Company

Contractor

## COMPLETE

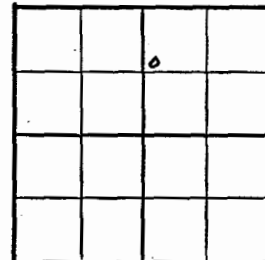
SW NW NE

## SECTION PLAT

990 Ft. from N. Line

\_\_\_\_\_ Ft. from S. Line

\_\_\_\_\_ Ft. from E. Line

330 Ft. from W. Line

Wabaunsee County

Location \_\_\_\_\_

## RECORD

Cased \_\_\_\_\_ in., \_\_\_\_\_ ft.

Sand \_\_\_\_\_

Gas \_\_\_\_\_

Oil \_\_\_\_\_

Total Depth 3183

## PRODUCTION

1st 24 hrs. Nat. \_\_\_\_\_

1st 24 hrs. after shot \_\_\_\_\_

Gas \_\_\_\_\_ Cu. Ft.

Dry Hole \_\_\_\_\_

Abandoned \_\_\_\_\_

Date

NOV 23 1949

19

S. J. LEWIS

Scout

Wabaunsee

Sec. 4 Twp. 14 R. 10-E

Well No. #3 Davis "B" Farm

Carter

Company

Davis Ranch

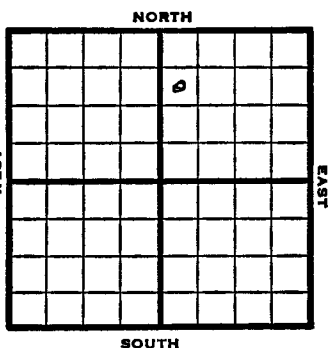
990 Ft. from N. Line

Ft. from S. Line

Ft. from E. Line

330 Ft. from W. Line

SW NW NE



1949 Elev 1401' REPORT

10/12 Location

10/19 "

10/26 Lansing 1522'

KC 1685'

Drlg. 2150'

11/1 Miss 2455'

Hunton 2955'

Viola 3163'

TD 3183'

Run 7"

11/9 7" @ 3165'

Swb 339 bbls oil 4 hrs.

11/23 TD 3183'

Viola 3163'

7" @ 3165'

Echo Pot 3000 Oil

29° Gr.

Comp

COMPLETED

KANSAS

Wabaunsee

Section 4 Township 14S Range 10E

Well No. #3 Davis "B"

Company Carter Oil Co.

