

Map No. _____ Sec. 4 Twp. 14 R. 10E

Well No. 2 Davis "B"

_____ Carter _____ Company

_____ Contractor

SW SE NW

**FIRST REPORT
SECTION PLAT**

_____ Ft. from N. Line

330 Ft. from S. Line

990 Ft. from E. Line

_____ Ft. from W. Line

Wabaunsee County

Location X

Rig up _____

Drilling and Remarks:

RECORD
 Cased _____ in., _____ ft.
 Sand _____
 Gas _____
 Oil _____
 Total Depth _____

PRODUCTION
 1st 24 hrs. Nat. _____
 1st 24 hrs. after shot _____
 Gas _____ Cu. Ft.
 Dry Hole _____
 Abandoned _____

Date

SEP 28 1949 19 S. J. LEWIS Scout

Map No. _____ Sec. 4 Twp. 14 R. 10E

Well No. 2 Davis "B"

_____ Carter _____ Company

_____ Contractor

SW SE NW

COMPLETE

E11405

SECTION PLAT

_____ Ft. from N. Line

330 Ft. from S. Line

990 Ft. from E. Line

_____ Ft. from W. Line

Wabaunsee County

Location _____

Rig up _____

Drilling and Remarks:

*Vista 3159
2" @ 3155
Bony P. T. 3000 oil*

PRODUCTION
 1st 24 hrs. Nat. _____
 1st 24 hrs. after shot _____
 Gas _____ Cu. Ft.
 Dry Hole _____
 Abandoned _____

Date

NOV 9 1949 19 S. J. LEWIS Scout

KANSAS

Wabaunsee

Sec. 4 Twp. 14 R. 10E

Well No. 2 Davis "B" Farm _____

Company Carter

Davis Ranch Pool


_____ Ft. from N. Line

330 Ft. from S. Line

990 Ft. from E. Line

_____ Ft. from W. Line

SW SE NW

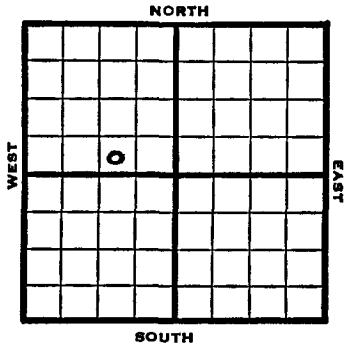

1949 ^{1405'}
Elev. 1399' **REPORT**

- 9/28 **Loc.**
- 10/5 10" @ 185'
- Howard 873'
- Topeka 946'
- Lansing 1529'
- KC 1672'
- Drlg 1785'
- 10/12 Miss 2470'
- Drlg 2620'
- 10/19 Hunton 2968'
- Viola 3189'
- TD 3203'
- 7" @ 3188'
- 10/26 2900' oil 1 1/2 hrs.
- 11/1 "
- 11/9 TD 3205'
- Viola 3189'
- 7" @ 3188'
- Bomb Pot 3000 Oil
- 39th Gr.
- Camp

COMPLETED

KANSAS

Wabaunsee

Section 4 Township 14 Range 10E

Well No. 2 Davis "B"

Company Carter

Davis Ranch
NORTH

