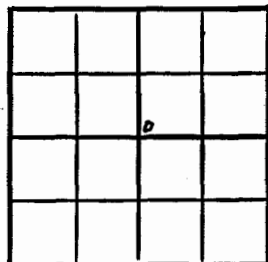


Map No. _____ Sec. 4 Twp. 14 R. 10EWell No. 4 Davis "B"

Carter _____ Company

Atikins Drlg. _____ Contractor

SW NE

FIRST REPORT
SECTION PLAT

_____ Ft. from N. Line

330 Ft. from S. Line

_____ Ft. from E. Line

330 Ft. from W. Line

Wabaunsee County

Location X

Rig up _____

Drilling and Remarks:

RECORD

Cased _____ in. _____ ft.

Sand _____

Gas _____

Oil _____

Total Depth _____

PRODUCTION

1st 24 hrs. Nat. _____

1st 24 hrs. after shot _____

Gas _____ Cu. Ft.

Dry Hole _____

Abandoned _____

Date


OCT 26 1949 19S. J. LEWIS ScoutMap No. _____ Sec. 4 Twp. 14 R. 10EWell No. 4 Davis "B"

Carter _____ Company

COMPLETE

Contractor

SW NE

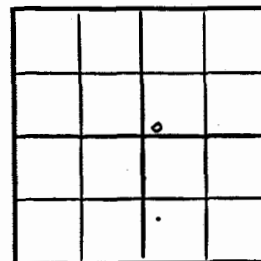E. 1396
SECTION PLAT

_____ Ft. from N. Line

330 Ft. from S. Line

_____ Ft. from E. Line

330 Ft. from W. Line

Wabaunsee County

Location _____

Rig up _____

Drilling and Remarks:

Water 21747" CO 176Ec. let Bx 3000 m.

RECORD

Cased _____ in. _____ ft.

Sand _____

Gas _____

Oil _____

Total Depth 3171

PRODUCTION

1st 24 hrs. Nat. _____

1st 24 hrs. after shot _____

Gas _____ Cu. Ft.

Dry Hole _____

Abandoned _____

Date

DEC 21 1949 19S. J. LEWIS Scout

Wabaunsee

KANSAS

Sec. 4 Twp. 14 R. 10E

Well No. #4 Davis "B" Farm

Carter

Company

Atikins Drlg.

Contractor

Davis Ranch


Ft. from N. Line

330' Ft. from S. Line

Ft. from E. Line

330' Ft. from W. Line

SW NE

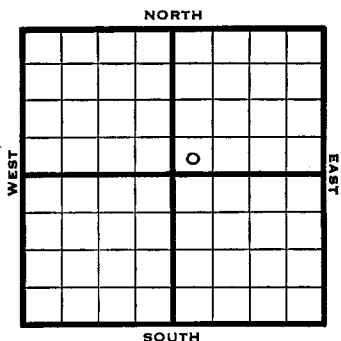

1949 Elev 1396' REPORT

10/26	Location	
11/1	"	
11/9	10" @ 160'	
	Drlg. 1190'	
11/16	Topeka 944'	1887
	Lansing 1527'	1396
	KC 1674'	49'
	BKC 1887'	
	Miss 2455'	
	Drlg 2467'	
11/23	Hunton 2971'	
	Viola 3174-91'	
	TD 3191'	
	7" @ 3176'	
11/29	"	
12/7	Swb 303 bbls oil 3 hrs.	
12/14	"	
12/21	TD 3191'	
	Viola 3174'	
	7" @ 3176'	
	Echo Pet 3000 Oil	
	277 Gr.	
	Comp	

COMPLETED

KANSAS

Wabaunsee

Section 4 Township 14 Range 10-E

Well No. #4 Davis "B"

Company Carter

Davis Ranch

