

Map No. _____ Sec. 12 Twp. 14 R. 10E

Well No. 1 Lockhart

J. S. Abercrombie _____ Company

_____ Contractor

NW SW NW


El. 1416
SECTION PLAT

_____ Ft. from N. Line

990 _____ Ft. from S. Line

_____ Ft. from E. Line

330 _____ Ft. from W. Line

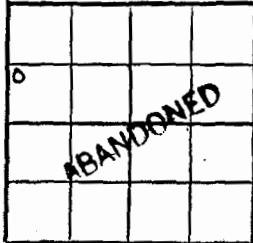

Waubaussee

Location _____

Rig up _____

Drilling and Remarks:

10" C 170
Heb. 1300
Lans. 1567
K.C. 1725
B.K.C. 1930
Cherokee 2168
Burgess 2568

RECORD

Cased _____ in. _____ ft.

Sand _____

Gas _____

Oil _____

Total Depth 3515

PRODUCTION

1st 24 hrs. Nat. _____

1st 24 hrs. after shot _____

Gas _____ Cu. Ft.

Dry Hole _____

Abandoned _____

Date

MAY 31 1950 19

J. E. TYRA Scout

Miss. 2580
Kinderhook 2916
Huntan 3096
Por. 3096-3107 NS
Mag. 3220
Violet 3292
Simp. 3400
Art. 3475
T.D. 3515

D+A

9 NOV 1951

Kansas

Wildcat

KANSAS

Waubaunsee

Map No. _____ Sec. 12 Twp. 14 R. 10E

Sec. 12 Twp. 14 R. 10E

Well No. Lockhart

Well No. #1 Lockhart Farm _____

J. S. Abercrombie Company


J. S. Abercrombie Company

Murfin Contractor

Murfin Contractor

NW SW NW

SECTION PLAT

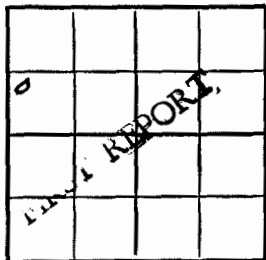

_____ Ft. from N. Line

990 Ft. from S. Line

_____ Ft. from E. Line

330 Ft. from W. Line

Waubaunsee
~~Waubunsee~~

Wildcat

_____ Ft. from N. Line


990 Ft. from S. Line

_____ Ft. from E. Line

330 Ft. from W. Line

NW SW NW

NORTH

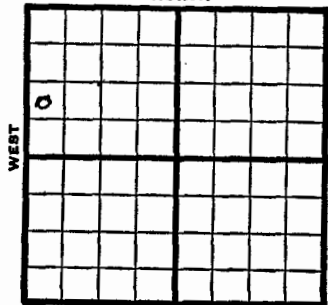

SOUTH

Location _____

RECORD

Cased _____ in., _____ ft.

Sand _____

Gas _____

Oil _____

Total Depth _____

PRODUCTION

1st 24 hrs. Nat. _____

1st 24 hrs. after shot _____

Gas _____ Cu. Ft.

Dry Hole _____

Abandoned _____

Date _____

MAY 10

19

J. E. TYRA Scout

Elev. 1416' REPORT

1950

5/10

Location

5/31

10" @ 170'

Heeb 1300'

Lans. 1567'

KC 1725

BKC 1930'

Cherokee 2168'

Burgess 2568'

Simp. 3400'

TD 3515'

D&A

ABANDONED

Miss 2580'

Kinderhook 2916'

Hunton 3096'

Por. 3096+3107' NS

Maq. 3220'

Viola 3292'

Arb. 3475'

$\frac{3096}{2580}$
5'6"

$\frac{3400}{3096}$
304

$\frac{3400}{1486}$
-1984

15-197-0011
FORM 51 25M 3-49 PETROL

KANSAS ✓

Section 12 Township 14 Range 10 E

Well No. Lockhart

Company J.S. Abercrombie

