

County Waubensee State Kansas

Sec. 17 (Blk. Twp.) 14 (Sur. Rge.) 10E Map No.

Operator Carter Oil

Well No. 1 Farm Burrow - Wingate "A"

Elev. _____ Location SE SE SE

FIRST REPORT

330 Ft. From S Line SE

330 Ft. From E Line Quarter

1st. Report SEP 27 1950

Completion _____

Remarks Adkins Drlg. - Contr.

Spudding Date _____

Drlg. Data

WildcatLocation

J. E. TYRA

County Waubunsee State Kansas

Sec. 17 (Blk. Twp.) 14 (Sur. Rge.) 10E Map No.

Operator Carter Oil

Well No. 1 Farm Burrow - Wingate "A"

Elev. 1528 Location SE SE SE

ABANDONED

330 Ft. From S Line SE

330 Ft. From E Line Quarter

1st. Report _____

Completion NOV 1 1950

Remarks Wildcat

Adkins Drlg. - Contr.

Spudding Date 10-10-50

Drlg. Data

D & ATD 33988 5/8" @ 180 Howard 1025 Top. 1090Heeb. 1405 Lans. 1685 KC 1818B KC 2041 Miss. 2658 Miss. dol. 2666Kinderhook 2974 Hunton 3138 Maq. 3307Viola 3395 DST 3395-98 open 2 hr.Rec. 360' water TD 3398D & A

J. E. TYRA

Waubansee KANSAS

Sec. 17 Twp. 14 R. 10E ✓

Well No. #1 Burrow - Wingate "A" Farm

Carter Oil Company

Adkins Drlg. Contractor

Wildcat


Ft. from N. Line

330' Ft. from S. Line

330' Ft. from E. Line

Ft. from W. Line

SE SE SE

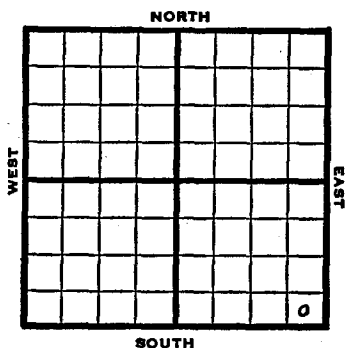

1950 Elev. 1528' REPORT

9/27 Location

11/1 Spud 10-10-50
D&A TD 3398'
8-5/8" @ 180'
Howard 1025' Top 1090'
Heeb. 1405' Lans 1685'
KC 1818 BKC 2041
Miss 2658' Miss Dol 2666'
Kinderhook 2974' Hunton 3138'
Mzq. 3307' Viola 3395'
DST 3395-98 opn 2 hr.
Rec. 360' wtr TD 3398'
D&A

ABANDONED

3138
2658
480

Section 17 Township 14 Range 10E

Well No. #1 Burrow - Wingate "A"

Company Carter Oil

