

Kansas

Map No. _____ Sec. 20 Twp. 14 R. 10E

Well No. 1 Chas. Olson

Carter _____ Company

Honaker _____ Contractor

SW NW SE


FIRST REPORT
SECTION PLAT

990 Ft. from N. Line

Ft. from S. Line

Ft. from E. Line

330 Ft. from W. Line

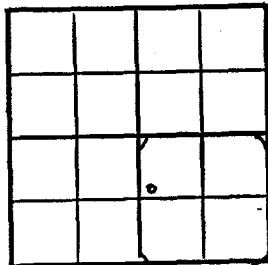

Wabaunsee County

Location X

Rig up

Drilling and Remarks:

RECORD

Cased _____ in., _____ ft.

Sand _____

Gas _____

Oil _____

Total Depth _____

PRODUCTION

1st 24 hrs. Nat. _____

1st 24 hrs. after shot _____

Gas _____ Cu. Ft.

Dry Hole _____

Abandoned _____

Date

DEC 31 19

S. J. LEWIS

Scout

Sec. 20 Twp. 14 R. 10E

Well No. #1 Chas. Olson _____ Farm

Carter _____ Company

Wildcat (Honaker, Contr.) NORTH


990' Ft. from N. Line

Ft. from S. Line

Ft. from E. Line

330' Ft. from W. Line

SW NW SE

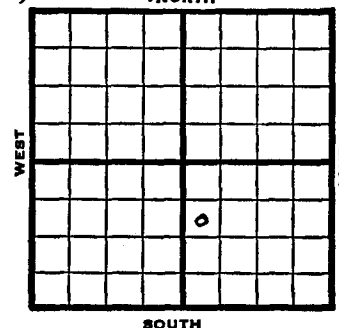

1949

REPORT

12/21

Location

12/28

10" @ 186'

Drlg 460'

1950
1/18

TD 3490'

10" @ 186'

DST 3404-16

Rec 105 bbls sulphur 2 hrs.

D&A

Tops:

Howard 982'

Torrington 1046'

Heb 1365'

Lans 1650'

KC 1798'

BKC 2006'

Miss 2602'

Hunton 3078'

Viola 3292'

Simpson 3396'

Arb. 3474-90 TD

Aband.

ABANDONED

Kansas

Wildcat

Map No. _____ Sec. 20 Twp. 14 R. 10E

Well No. 1 Chas. Olson

Carter _____ Company

Contractor _____

SW NW SE


SECTION PLAT

990 Ft. from N. Line

_____ Ft. from S. Line

_____ Ft. from E. Line

330 Ft. from W. Line

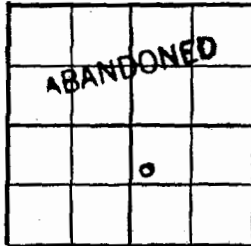

Wabaunsee County

Location _____

Rig up _____

Drilling and Remarks:

10" @ 186

D.S.T. 3404-16

rec. 105 Bbl/s

sulphur 2 hrs.

D & A

(Tops over)

Date

JAN 18 1950

19

J. E. TYRA

Scout

RECORD

Cased _____ in, _____ ft.

Sand _____

Gas _____

Oil _____

Total Depth 3490

PRODUCTION

1st 24 hrs. Nat. _____

1st 24 hrs. after shot _____

Gas _____

Cu. Ft.

Dry Hole _____

Abandoned _____

Harwood - 982
 Jovington - 1046
 Heb - 1365
 San - 1650
 K.C. - 1798
 BKC - 2006
 Miss - 2602
 Hutton - 3078
 Viola - 3292
 Simpson - 3396
 Arb - 3474 - 90 T.D.

Scout Cards	<i>Edith</i>
Land Survey M. 2	
Land W. 1 M	
The Land	
Plat No.	
Plat No.	
Plat No.	

JAN 20 1950

15-197-00107
FORM 51 10M 2-49 PETROL

Wabaunsee KANSAS ✓

Section 20 Township 14 Range 10E

Well No. #1 Chas. Olson

Company Carter

Wildcat

NORTH

WEST

EAST

SOUTH

0