


Map No. _____ Sec. 21 Twp. 14 R. 10E

Well No. 1 Hack

Sterling Drlg. Company

Contractor

E1. 1502
SECTION PLAT

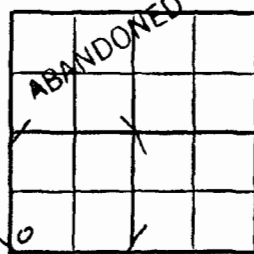

Ft. from N. Line

330 Ft. from S. Line

Ft. from E. Line

330 Ft. from W. Line

Wabaunsee County

Location

Rig up

Drilling and Remarks:

8" C 160

Howard 992

Zogger 1051

Neubner 1370

Rans. 1646

K.C. 1797

B.K.C. 2002

RECORD

Cased _____ in. _____ ft.

Sand _____

Gas _____

Oil _____

Total Depth 3472

PRODUCTION

1st 24 hrs. Nat. _____

1st 24 hrs. after shot _____

Gas _____ Cu. Ft.

Dry Hole _____

Abandoned _____

Date

APR 26 19 _____ J. E. TYRA Scout

Miss. chat 2616
Lime 2613
dolomite 2638
Mag. 32025
Huntow 3076
DST MAY 3283-87

open 30 min.
Rec. 1860' water
Vial 3282
Simp. dol. 3382
Simp. sd. 3403
SO 3403-06
DST 3400-06

open 1 hr.
Rec. 40' black oil 40' sulphur water
BHP 1055#
arb 3460-72 T.D.
D+A

Kansas

Wildcat

Waubanunsee KANSAS

Sec. 21 Twp. 14 R. 10E

Map No. _____ Sec. 21 Twp. 14 R. 10E

Well No. 1 Hack

Sterling Drlg. Company

Sterling Drlg. Contractor

SW SW SW

SECTION PLAT



Ft. from N. Line

330 Ft. from S. Line

Ft. from E. Line

330 Ft. from W. Line

Waubanunsee County

Carter DHM

RECORD

Cased _____ in., _____ ft.
Sand _____
Gas _____
Oil _____
Total Depth _____

PRODUCTION

1st 24 hrs. Nat. _____
1st 24 hrs. after shot _____
Gas _____ Cu. Ft.
Dry Hole _____
Abandoned _____

Date

APR 12 1950 19

J. E. TYRA Scout

Well No. #1 Hack Farm

Sterling Drlg. Company

Sterling Drlg. Contractor

Wildcat


Ft. from N. Line

330' Ft. from S. Line

Ft. from E. Line

330' Ft. from W. Line

SW SW SW

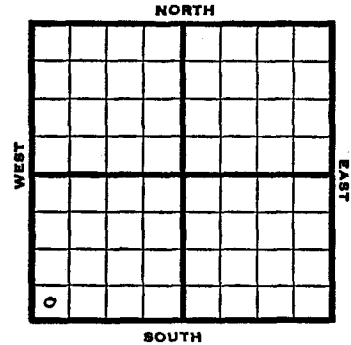

1950 Elev 1502' REPORT

4/12 Spud 4-8-50
8" @ 160'
Drlg. 925'

4/26 TD 3472'
8" @ 160'
Howard 992'
Topeka 1051'
Heebner 1370'
Lans 1646'
KC 1797'
BKC 2002'

Miss Chat 2616'
Lime 2613'
Dolomite 2638'
Maq 3202
Hunton 3076'
DST 3283-87
opn 30 mins.
Rec 1860' wtr.
Viola 3282'
SimpnDolo 3382'
Simp sd 3403
SO 3403-06
DST 3400-06 opn 1 hr
Rec 40' black oil
40' sulphur wtr.
BHP 1055#
Arb. 3460-72 TD
D&A
Aband. **ABANDONED**

3403
3076
327 - 1907

3076
2616
460

2002
1502
500

Waubunsee KANSAS

Section 21 Township 14 Range 10E

Well No. #1 Hack

Company Sterling Drlg.

