

Map No. _____ Sec. 22 Twp. 14 R. 10E


Well No. 1 Schultz

B & R Drlg. _____ Company

B & R Drlg. _____ Contractor

SE NW

**FIRST REPORT
SECTION PLAT**

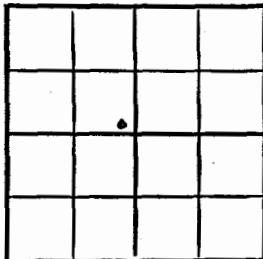

_____ Ft. from N. Line

330 _____ Ft. from S. Line

330 _____ Ft. from E. Line

_____ Ft. from W. Line

Wabaunsee County

Location _____

Rig up _____

Drilling and Remarks:

Spud

RECORD

Cased _____ in., _____ ft.

Sand _____

Gas _____

Oil _____

Total Depth _____

PRODUCTION

1st 24 hrs. Nat. _____

1st 24 hrs. after shot _____

Gas _____ Cu. Ft.

Dry Hole _____

Abandoned _____

Date

AUG 31 1949 19

S. J. LEWIS Scout

Map No. K99 Sec. 22 Twp. 14 R. 10E


Well No. 1 Schultz

B & R Drlg. etal. _____ Company

ABANDONED

SE NW

SECTION PLAT

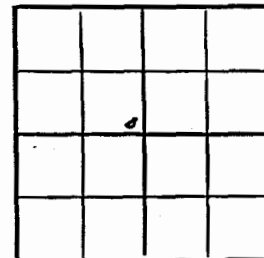

_____ Ft. from N. Line

330 _____ Ft. from S. Line

330 _____ Ft. from E. Line

_____ Ft. from W. Line

Wabaunsee County

Location _____

Rig up _____

Drilling and Remarks:

Miner 3208

Miner 3212

Vista 3417

Spring 3512

Box 3593

RECORD

Cased _____ in., _____ ft.

Sand _____

Gas _____

Oil _____

Total Depth *3214*

PRODUCTION

1st 24 hrs. Nat. _____

1st 24 hrs. after shot _____

Gas _____ Cu. Ft.

Dry Hole _____

Abandoned _____

Date

SEP 21 1949 19

S. J. LEWIS Scout

Wabaunsee

KANSAS
10E

Sec. 22 Twp. 14 R. 10E

Well No. #1 Schultz Farm

B & R Drlg.

Company

Wildcat (B & R Drlg., Cont.)

NORTH


Ft. from N. Line

330' Ft. from S. Line

330' Ft. from E. Line

Ft. from W. Line

SE NW

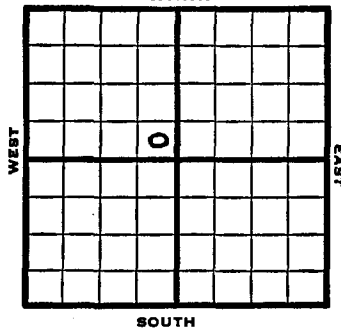

1949 Elev 1515' REPORT

8/31 Spud

9/7 8" @ 188'

KC 1886'

Drlg. 1876'

9/14 Lansing 1685'

KC 1833'

BKC 2043'

Burgess 2680'

Miss 2695'

Kinderhook 2997'

Drlg 3123'

9/21 TD 3614'

Misiner 3208'

Hunton 3212'

Viola 3417'

Simp 3522'

Arb. 3593'

Aband.

ABANDONED

3212
2695
517
3522
3212
310
3522
1515
2007

FORM 51

M 48 PETROL

KANSAS

15-197-00051 Wabaunsee

Section 22 Township 14 Range 10E

Well No. 1 Schultz

Company B & R Drlg.

Wildcat
NORTH

