

Map No. _____ Sec. 23 Twp. k4 R. 10E


Well No. 1 Converse

El Capitan Company

Glen Nye Contractor

SW NE

FIRST REPORT
SECTION PLAT

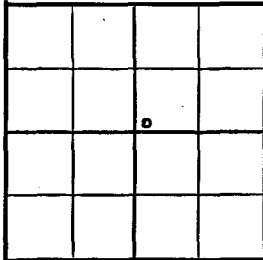

_____ Ft. from N. Line

330 Ft. from S. Line

_____ Ft. from E. Line

330 Ft. from W. Line

Wabaunsee County

Location X

RECORD

Cased _____ in., _____ ft.

Sand _____

Gas _____

Oil _____

Total Depth _____

PRODUCTION

1st 24 hrs. Nat. _____

1st 24 hrs. after shot _____

Gas _____ Cu. Ft.

Dry Hole _____

Abandoned _____

Date

NOV 16 1949 19

S. J. LEWIS Scout

Map No. _____ Sec. 23 Twp. 14 R. 10E

Well No. 1 Converse


El Capitan Company

ABANDONED

Contractor

SW NE

E11526
SECTION PLAT

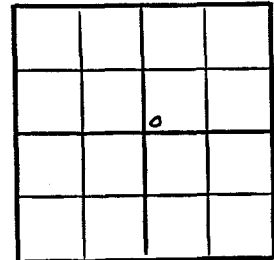

_____ Ft. from N. Line

330 Ft. from S. Line

_____ Ft. from E. Line

330 Ft. from W. Line

Wabaunsee County

Location _____

RECORD

Cased _____ in., _____ ft.

Sand _____

Gas _____

Oil _____

Total Depth 3409

PRODUCTION

1st 24 hrs. Nat. _____

1st 24 hrs. after shot _____

Gas _____ Cu. Ft.

Dry Hole _____

Abandoned _____

Date

DEC 21 1949 19

S. J. LEWIS Scout

Wabaunsee KANSAS

Wabaunsee
KANSAS

Sec. 23 Twp. 14 R. 10E

Section 23 Township 14 Range 10-E

Well No. #1 Converse Farm

Well No. #1 Converse



El Capitan Company

Company El Capitan

Wildcat (Glen Nye, Contr.)

Wildcat

Ft. from N. Line
330'
Ft. from S. Line
Ft. from E. Line
330'
Ft. from W. Line

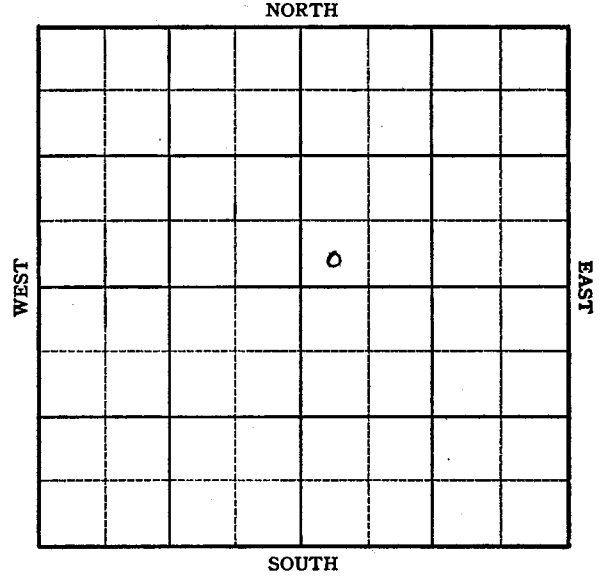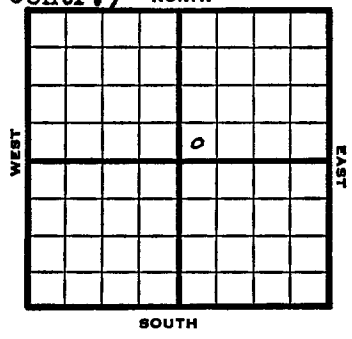

SW NE

| 1949 | Elev 1526' | REPORT |
|-------|------------------|------------|
| 11/16 | Location | |
| 11/23 | " | |
| 11/29 | " | |
| 12/7 | 8" @ 210' | Drlg 1431' |
| 12/14 | Lansing 1669' | KC 18.3' |
| | BKC 2057' | Miss 2692' |
| | Drlg. 2707' | |
| 12/21 | TD 3409' | |
| | Hunton 3208' | |
| | Viola 3392' | |
| | Aband. | |
| | ABANDONED | |

*3208
2692
510*