

County	Waubaussee		State	Kansas
Sec.	32 (Blk. Twp.)	14 (Sur. Rge.)	10E	Map No.
Operator	Valley Steel Products			
Well No.	1	Farm	Eldridge	
Elev.	Location SE SE NW			
		330 Ft. From S Line NW		
		330 Ft. From E Line Quarter		
		1st. Report OCT 1 1952		
		Completion		
Remarks		Carter acreage		
Pam-Kar - Contr.				
Spudding Date				
Drig. Data	Wildcat			
M I R				

J. G. McGEHEE

County	Waubaussee		State	Kansas
Sec.	32 (Blk. Twp.)	14 (Sur. Rge.)	10E	Map No.
Operator	Valley Steel Products			
Well No.	1	Farm	Eldridge	
Elev.	1487	Location SE SE NW		
		330 Ft. From S Line NW		
		330 Ft. From E Line Quarter		
		1st. Report		
		Completion	OCT 15 1952	
Remarks		Wildcat		
Pam-Kar - Contr.				
Spudding Date		9-30-52		
Drig. Data	D & A TD 3396			
Heeb. 1348 Lans. 1630 KC 1783				
B KC 2007 Miss. 2580 Line 2593				
Kh. 2910 Hunton 3065 Maq. 3196				
Viola 3261 good show oil 3262-73				
DST 3262-73 open 40 min. Rec. 1920' wtr.				
Decora 3342 Simp. 3376 TD 3396				
D & A				

J. G. McGEHEE

Waubansee

KANSAS

Sec. 32 Twp. 14 R. 10E

Well No. #1 Eldridge Farm

Valley Steel Products Company

Pam-Kar Contractor

Wildcat

Ft. from N. Line


330 Ft. from S. Line

330 Ft. from E. Line

Ft. from W. Line

SE SE NW

Carter acreage

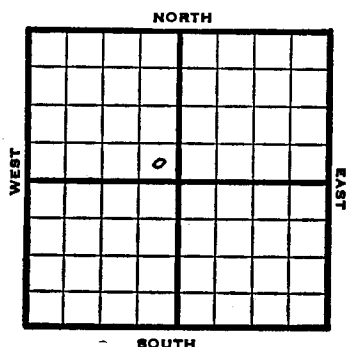

1952 Elev. 1487' REPORT

10/1 MIR
10/15 Spud 9-30-52
D&A TD 3396'

Heeb. 1348 Lans. 1630
KC 1783 B KC 2007
Miss. 2580 Li 2593
Kh 2910 Hunton 3065
Maq. 3196 Viola 3261
Good show oil 3262-73
DST 3262-73 open 40 min. rec. 1920'
wtr.
Decora 3342 Simp. 3376
TD 3396 D&A

ABANDONED

3065
2580
495

3376
3065
311

3376
1487
1889

15-197-00084

FORM 51 25M 3-49 PETROL

Waubansee

KANSAS

Section 32 Township 14 Range 10E

Well No. #1 Eldridge

Company Valley Steel Products

