

Map No. Kans Sec. 6 Twp. 14 R. 14E
 Well No. 1 Hughes
R. G. Gallup Company
 Contractor

FIRST REPORTS

SECTION PLAT

_____ Ft. from N. Line
330' Ft. from S. Line
 _____ Ft. from E. Line
330' Ft. from W. Line

Location _____

Rig up _____

Drilling and Remarks:

400'

RECORD

Cased _____ in., _____ ft.

Sand _____

Gas _____

Oil _____

Total Depth _____

PRODUCTION

1st 24 hrs. Nat. _____

1st 24 hrs. after shot _____

Gas _____ Cu. Ft.

Dry Hole _____

Abandoned _____

Date

7/23 1924 M. A. B. Scout

Map No. KANSAS Sec. 6 Twp. 14 R. 14E
 Well No. 1 Hughes
R. G. Gallup Company
 Contractor

ABANDONED

SECTION PLAT

_____ Ft. from N. Line
330' Ft. from S. Line
 _____ Ft. from E. Line
330' Ft. from W. Line

Location _____

Rig up _____

Drilling and Remarks:

LO + A
2458'

RECORD

Cased _____ in., _____ ft.

Sand _____

Gas _____

Oil _____

Total Depth _____

PRODUCTION

1st 24 hrs. Nat. _____

1st 24 hrs. after shot _____

Gas _____ Cu. Ft.

Dry Hole _____

Abandoned _____

Date

SEP 9 1924

M. A. BENEAT

192


Scout

Map No. 7 Sec. 6 Twp. 14 R. 14Well No. 1 Hughes FarmR. G. Gillespie Company

Ft. from N. Line

330 Ft. from S. Line

Ft. from E. Line

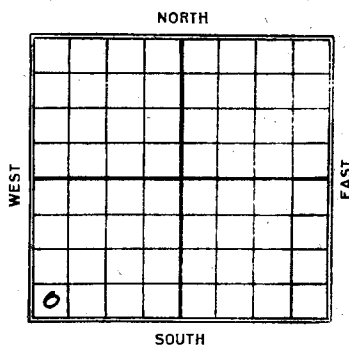330 Ft. from W. Line


REPORT

Date 1/24/
7/23 400'
9/9 NO S.D.A. 2458

15-139-00021

Map No. _____ Sec. 6 Twp. 14 R. 14^EWell No. 1 Hughes FarmR. G. Gillespie Company

NORTH

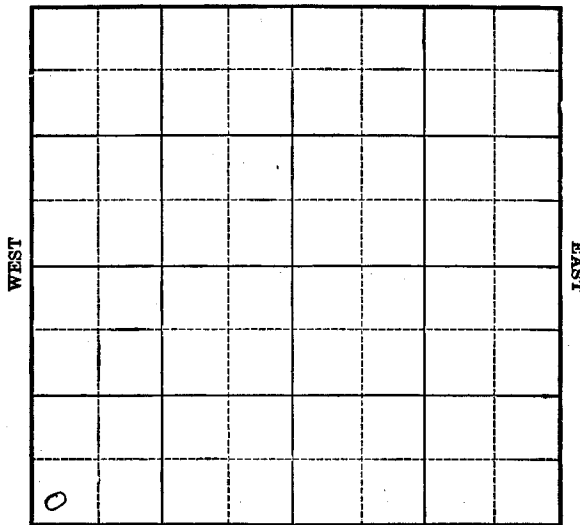

SOUTH

Location _____

Drilling Remarks:

Rig Up _____

Drilling Remarks:

RECORD

Cased _____ in. _____ ft.

Sand _____

Gas _____

Oil _____

Total Depth _____

PRODUCTION

1st 24 hrs. Nat. _____

1st 24 hrs. after shot _____

Gas _____ cu. ft.

Dry Hole _____

Abandoned _____