


Map No. **KANSAS** Sec. **21** Twp. **14** R. **15**
 Well No. **1** - **Wood** Farm
~~Raymond & Smith~~ Company
Caume et al NORTH

Ft. from N. Line
660 Ft. from S. Line
660 Ft. from E. Line
 Ft. from W. Line
1930

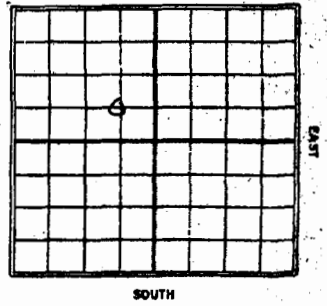

Date	REPORT
6/18	Drill 160'
6/25	—
7/2	—
7/9	—
7/16	—
7/23	S.D. 160'
7/30	— 11/19 —
8/6	— 11/26 —
8/13	— 12/3 —
8/20	— 12/10 —
8/27	— 12/17 —
9/3	— 12/23 —
9/10	— 12/30 —
9/17	— 1931 —
9/24	— 1/7 —
10/1	— (over) —
10/8	—
10/15	—
10/22	—
10/29	—
11/5	—
11/12	—

1/14 - Show oil & gas 950
 SD 1050' for 10"

- 1/21 —
- 1/28 - No report
- 2/4 - SD 1050'
- 2/11 —
- 2/18 —
- 2/25 —
- 3/3 —
- 3/11 —
- 3/18 —
- 3/25 —
- 4/1 —
- 4/8 - Drill 1700'
- 4/15 - SD 1700'
- 4/22 — 8/26 —
- 4/29 — 9/2 —
- 5/6 — 9/9 —
- 5/13 — 9/16 —
- 5/20 —
- 5/27 —
- 6/3 —
- 6/10 —
- 6/17 —
- 6/24 —
- 7/1 —
- 7/8 —
- 7/15 —
- 7/22 —
- 7/29 —
- 8/5 —
- 8/12 —
- 8/19 —

Map No. Kans Sec. 21 Twp. 14 R. 15^E


Well No. T-1 Wood Farm
Breggs & Smith Company

_____ Ft. from N. Line

_____ Ft. from S. Line

_____ Ft. from E. Line

_____ Ft. from W. Line

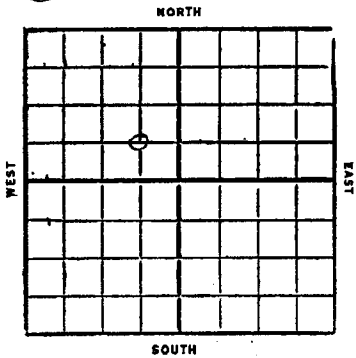

1931

Date	REPORT
9/23	Top line 1845 517 2058'
9/30	2/10
10/7	2/17
10/14	2/26
10/21	3/2
10/28	3/9
11/4	3/16
11/10	3/22
11/18	3/30
11/24	4/6
12/2	4/13
12/9	4/20
12/16	4/27
12/23	5/4
12/30	5/11
1932	5/18
1/6	5/25- Top line 1845
1/13	TD. 2058
1/20	Dry & Abandon
1/27	(over)
2/3	

1932

8/31-

OWDD

Old TD 2058

SD 2627

(Think top Siliceous lime)

- 9/7
- 9/14
- 9/21
- 9/30
- 10/5
- 10/12
- 10/19
- 10/26
- 11/2
- 11/9
- 11/16
- 11/23
- 11/30
- 12/7
- 12/14
- 12/21
- 12/28
- 1933
- 1/3
- 1/11
- 1/18-
- 1/25
- 2/1
- 2/8
- 2/15
- 2/22
- 3/4
- 3/18

3/15

3/22

3/29

4/4

4/12

4/9 J.A. 2627'

Abandoned

6"- 2624

SD. 2627

Map No. **KANSAS** Sec. 21 Twp. 14 R. 15E

Well No. 1 Hood

Briggs & Smith Company
Contractor

FIRST REPORTS

SECTION PLAT

_____ Ft. from N. Line

660 Ft. from S. Line

660 Ft. from E. Line

_____ Ft. from W. Line

	0		

Location _____

Rig up _____

Drilling and Remarks:

Drly. 160

RECORD

Cased _____ in., _____ ft.

Sand _____

Gas _____

Oil _____

Total Depth _____

PRODUCTION

1st 24 hrs. Nat. _____

1st 24 hrs. after shot _____

Gas _____ Cu. Ft.

Dry Hole _____

Abandoned _____

Date **JUN 18 1930** **CHAS. L. SHERWOOD**
19 _____ Scout

Map No. **KANSAS** Sec. 21 Twp. 14 R. 15E

Well No. 1 Hood

Briggs & Smith Company
Contractor

COMPLETED

SECTION PLAT

_____ Ft. from N. Line

660 Ft. from S. Line

660 Ft. from E. Line

_____ Ft. from W. Line

	0		

ABANDONED

Location _____

Rig up _____

Drilling and Remarks:

Tap line 1845

RECORD

Cased _____ in., _____ ft.

Sand _____

Gas _____

Oil _____

Total Depth 2058

PRODUCTION

1st 24 hrs. Nat. _____

1st 24 hrs. after shot _____

Gas _____ Cu. Ft.

Dry Hole

Abandoned _____

Date **MAY 25 1932** **CHAS. L. SHERWOOD**
192 _____ Scout

98 KANSAS Map No. Sec. 21 Twp. 14 R. 15 E

Well No. 1 Wood

Gaume et al Company Contractor

FIRST REPORTS

SECTION PLAT

Ft. from N. Line
660 Ft. from S. Line
660 Ft. from E. Line
Ft. from W. Line


Premiums carried as Briggs & Smith.

Location
Rig up
Drilling and Remarks: Old T.D. 7058

RECORD
Cased in. ft.
Sand
Gas
Oil
Total Depth

S.D. 7627
Shin's Top up
Siliceous lens

PRODUCTION
1st 24 hrs. Nat.
1st 24 hrs. after shot
Gas Cu. Ft.
Dry Hole
Abandoned

Date
192 Scout

98 KANSAS Map No. Sec. 21 Twp. 14 R. 15 E

Well No. 1 Wood

Gaume et al Company Contractor

COMPLETE

SECTION PLAT

Ft. from N. Line
660 Ft. from S. Line
660 Ft. from E. Line
Ft. from W. Line


ABANDONED

Location
Rig up
Drilling and Remarks:

RECORD
Cased in. ft.
Sand
Gas
Oil
Total Depth 7627

PRODUCTION
1st 24 hrs. Nat.
1st 24 hrs. after shot
Gas Cu. Ft.
Dry Hole
Abandoned

Date APR 19 1933 CHAS. L. SHERWOOD 192 Scout

