

Douglas

E

Map No. KANSAS Sec. 10 Twp. 14 R. 19

Well No. 1 Churchbaugh

Hazlett Cr & Co Company

Contractor

FIRST REPORTS

SECTION PLAT

| | | | |
|---|--|--|--|
| | | | |
| | | | |
| | | | |
| | | | |
| 0 | | | |

..... Ft. from N. Line

660 Ft. from S. Line

..... Ft. from E. Line

660 Ft. from W. Line

Location.....

Rig up.....

Drilling and Remarks:

Dand 1240-1275

H F W

S. D.

RECORD

Cased..... in., ft.

Sand.....

Gas.....

Oil.....

Total Depth 1275

PRODUCTION

1st 24 hrs. Nat.....

1st 24 hrs. after shot.....

Gas..... Cu. Ft.

Dry Hole.....

Abandoned.....

Date

APR 5 1933 CHAS. L. SHERWOOD Scout

Douglas

E

Map No. KANSAS Sec. 10 Twp. 14 R. 19

Well No. 1 Churchbaugh

Hazlett Cr & Co Company

Contractor

SECTION PLAT

| | | | |
|---|--|--|--|
| | | | |
| | | | |
| | | | |
| | | | |
| 0 | | | |

..... Ft. from N. Line

660 Ft. from S. Line

..... Ft. from E. Line

660 Ft. from W. Line

Location.....

Rig up.....

Drilling and Remarks:

ABANDONED

RECORD

Cased..... in., ft.

Sand 1240-1275

Gas..... H F W

Oil.....

Total Depth 1275

PRODUCTION

1st 24 hrs. Nat.....

1st 24 hrs. after shot.....

Gas..... Cu. Ft.

Dry Hole

Abandoned


Date

APR 12 1933 CHAS. L. SHERWOOD Scout

Douglas KANSAS

Map No. _____ Sec. 10 Twp. 14 R. 19E

Well No. #1 Churchbaugh Farm
Hazlett et al Company

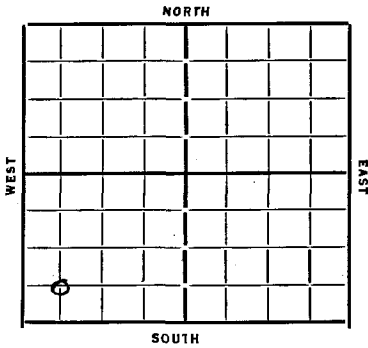

_____ Ft. from N. Line

660 Ft. from S. Line

_____ Ft. from E. Line

660 Ft. from W. Line

REPORT

Date 1933

4/5 Sand 1240-1275 H.F.W.
T.D. 1275 S.D.


4/12 sand 1240'-1275' H.F.W.
T.D. 1275'

Abandoned

Douglas

Map No. _____ Sec. 10 Twp. 14 R. 19E

Well No. 1 Churchbaugh Farm
Hazlett et al Company

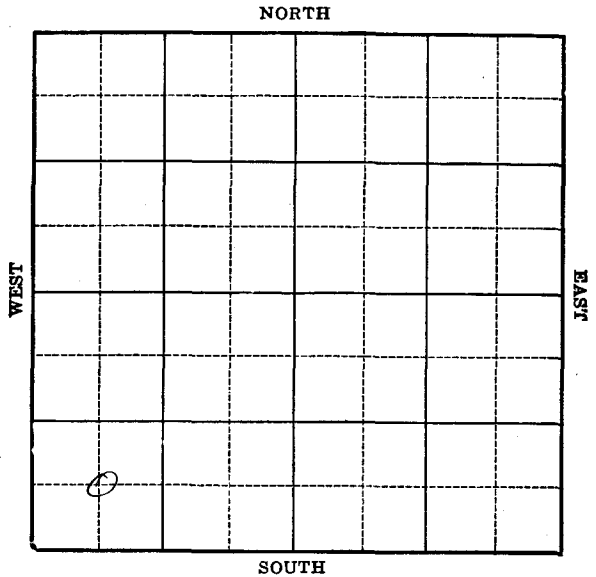

Location _____
Drilling Remarks _____

Rig Up _____
Drilling Remarks _____

RECORD
Cased _____ in. _____ ft.
Sand _____
Gas _____
Oil _____
Total Depth _____

PRODUCTION
1st 24 hrs. Nat. _____
1st 24 hrs. after shot _____
Gas _____ cu. ft. _____
Dry Hole _____
Abandoned _____