

County **Dickinson** State **Kansas**

Sec. **6** (Blk. **14** (Sur. **2E** Map No.

Operator **Continental**

Well No. **1** Farm **Rees**

Elev. Location **NE NW SW**

FIRST REPORT									
330 Ft. From N Line SW									
990 Ft. From W Line Quarter									
1st. Report APR 25 1951									
Completion									
Remarks Strat test									
Seismograph									
Spudding Date									
Drlg. Data Wildcat									
RUR									

J. E. TYRA

County **Dickinson** State **Kansas**

Sec. **6** (Blk. **14** (Sur. **2E** Map No.

Operator **Continental**

Well No. **1** Farm **Rees**

Elev. **1229** Location **NE NW SW**

330 Ft. From N Line SW									
990 Ft. From W Line Quarter									
1st. Report									
Completion JUN 20 1951									
Remarks Wildcat									
Spudding Date 4-22-51									
Drlg. Data D & A TD 3187									

8" @ 178 Heeb. 1604 Lans. 1766

Miss. 2354 DST 2369-75 open 1 hr.

Rec. 60' wcm 182' mud & SW Kh 2495

Hunton 2631 Maq. 2846 Viola 2940

Simp. 3057 Arb. 3126 TD 3187

D & A

J. E. TYRA

Dickinson KANSAS

Sec. 6 Twp. 14 R. 2 E

Well No. # 1 Rees Farm

Continental Company

Contractor


330 **Wildcat**
Ft. from N. Line

Ft. from S. Line

Ft. from E. Line

990 Ft. from W. Line

NE NW SW

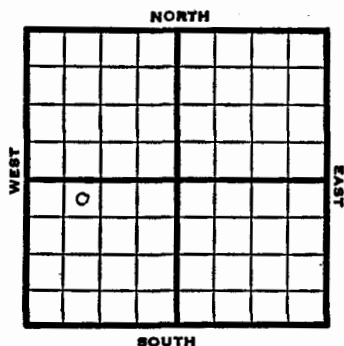


15-041-6410 00115
FORM 51 25M 8-50 WESTERN Dickinson KANSAS

Section 6 Township 14 Range 2 E

Well No. # 1 Rees

Company Continental

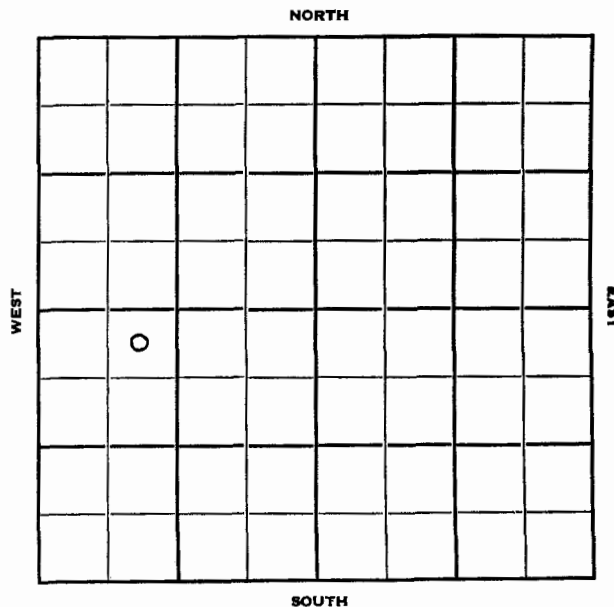

1951

Elev. 1229' REPORT

Strat test
Seismograph

4/25

R U R

6/20

Spud 4-22-51

D&A TD 3187

8" @ 178

Heeb. 1604 Lans. 1766

Miss 2354

DST 2369-75 opn 1 hr

Rec. 60' wcm 182' mud & SW

Kh 2495 Hunton 2631

Maq. 2846 Viola 2940

Simp. 3057 Arb. 3126

TD 3187

D&A

ABANDONED