

STATE CORPORATION COMMISSION OF KANSAS
OIL & GAS CONSERVATION DIVISIONWELL COMPLETION OR RECOMPLETION FORM
ACO-1 WELL HISTORY

DESCRIPTION OF WELL AND LEASE

Operator: license # 7880
 name Kansas Oil Properties, Inc.
 address 222 E. 3rd Street
 City/State/Zip Ottawa, Kansas 66067

Operator Contact Person James L. Mitchen
 Phone (913) 242-2700

Contractor: license # 5341
 name Evans Energy Development, Inc.

Wellsite Geologist NONE

PURCHASER Square Deal Oil Company, Inc.

Date Type of Completion
☒ New Well ☐ Re-Entry ☐ Workover

☒ Oil ☐ SWD ☐ Temp Abd
☐ Gas ☐ Inj ☐ Delayed Comp.
☐ Other (Core, Water Supply etc.)

If OWWO: old well info as follows:

Operator
 Well Name
 Comp. Date Old Total Depth

WELL HISTORY

Drilling Method: ☐ Mud Rotary ☒ Air Rotary ☐ Cable

7/24/84 7/26/84 8/11/84
 Sp. ate Date Reached TD Completion Date

765'
 Total Depth PBTD

Arr. t of Surface Pipe Set and Cemented at 42.5' feet

Multiple Stage Cementing Collar Used? ☐ Yes ☒ No

If Yes, Show Depth Set feet

If alternate 2 completion, cement circulated
 from feet depth to w/ SX cmt

Wireline Log Recd

TUBING RECORD size set at packer at

Liner Run ☐ Yes ☐ No

Date of First Production
 8/10/84

Producing method ☐ flowing ☒ pumping ☐ gas lift ☐ Other (explain)

Estimated Production
 Per 24 Hours

Oil
 10.0
 Bbls

Gas
 MCF

Water
 .2%
 Bbls

Gas-Oil Ratio
 CFPB

Gravity
 25.0

API NO. 15 - 045-20,609

County Douglas

NW 1/4 Sec 14 Twp 14 Rge 20

4786 FSL 4785 Ft North from Southeast Corner of Section
 3782 FEL 3795 Ft West from Southeast Corner of Section
 KCC Record (Note: locate well in section plat below)


Lease Name Woodhead Well# 17

Field Name Infield

Producing Formation Squirrel

Elevation: Ground KB

Section Plat

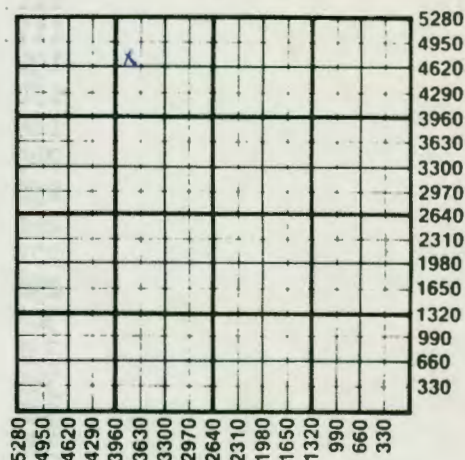

WATER SUPPLY INFORMATION

Source of Water:

Division of Water Resources Permit #

☐ Groundwater. Ft North From Southeast Corner and
 (Well) Ft. West From Southeast Corner of

Sec Twp Rge ☐ East ☐ West

☐ Surface Water. Ft North From Southeast Corner and
 (Stream, Pond etc.) Ft West From Southeast Corner

Sec Twp Rge ☐ East ☐ West

☐ Other (explain)
 (purchased from city, R.W.D.#)

Disposition of Produced Water: ☐ Disposal ☐ Repressuring

Docket #

SIDE TWO

☒ East☐ WestOperator Name Kansas Oil Properties, Inc. Lease Name Woodhead Well# 17 SEC 14 TWP. 14 RGE. 20

WELL LOG

INSTRUCTIONS: Show important tops and base of formations penetrated. Detail all cores. Report all drill stem tests giving interval tested, time tool open and closed, flowing and shut-in pressures, whether shut-in pressure reached static level, hydrostatic pressures, bottom hole temperature, fluid recovery, and flow rates if gas to surface during test. Attach extra sheet if more space is needed. Attach copy of log.

Drill Stem Tests Taken
 Samples Sent to Geological Survey
 Cores Taken

☐ Yes ☒ No
☐ Yes ☒ No
☐ Yes ☒ No

Topsoil & Clay	0	22
Shale	22	56
Lime	56	61
Shale	61	79
Lime	79	96
Shale	96	104
Lime	104	111
Shale	111	117
Lime	117	137
Shale	137	172
Lime	172	189
Shale	189	249
Lime	249	256
Shale	256	261
Lime	261	279
Shale	279	296
Lime	296	304
Shale	304	331
Lime	331	340
Shale	340	352
Lime	352	381
Shale	381	385
Lime	385	410
Shale	410	414
Lime	414	429
Shale	429	591
Lime	591	593
Shale	593	597
Lime	597	599
Shale	599	603
Lime	603	612
Shale	612	621
Lime	621	629
Shale	629	645

Formation Description
☐ Log ☐ Sample

Name	Top	Bottom
Lime	645	648
Shale	648	659
Lime	659	662
Shale	662	665
Lime	665	6
Shale	667	675
Lime	675	678
Shale	678	682
Lime	682	686
Shale	686	61
Lime	688	690
Shale	690	695
Broken Sand	695	696
Laminated	696	698
Solid Sand	698	70
Lime	701	702
Solid Sand	702	703
Lime	703	703.5
Broken Sand	703.5	706.5
Shale	706.5	765 T.I

Disposition of gas: ☒ vented
☐ sold
☒ used on lease

METHOD OF COMPLETION

☐ open hole ☒ perforation
☐ other (specify)

☐ Partially Completed.
☐ Commingled

CASING RECORD

☒ new☐ used

Report all strings set - conductor, surface, intermediate, production, etc.

Purpose of string	size hole drilled	size casing set (in O.D.)	weight lbs/ft.	setting depth	type of cement	# sacks used	type and percent additives
surface completion		6 1/4"		42.5'	portland		2% Gel
		2 7/8"		744.9'	portland		2% Gel

PERFORATION RECORD

Acid, Fracture, Shot, Cement Squeeze Record

shots per foot	specify footage of each interval perforated	(amount and kind of material used)	Depth
2/ft.			