

STATE CORPORATION COMMISSION OF KANSAS
OIL & GAS CONSERVATION DIVISION

WELL COMPLETION OR RECOMPLETION FORM
ACO-1 WELL HISTORY

DESCRIPTION OF WELL AND LEASE

Operator: license # 8357
name Maple Leaf Energy Corp.
address Box 451
City/State/Zip Baldwin City, Kansas 66006

Operator Contact Person Dwayne McCune
Phone (913) 594-2540

Contractor: license # 6193
name Hamm Drilling Inc.

Wellsite Geologist James Stegeman
Phone (913) 782-3191

PURCHASER

Designate Type of Completion
☒ New Well ☐ Re-Entry ☐ Workover

☐ Oil ☐ SWD ☐ Temp Abd
☐ Gas ☐ Inj ☐ Delayed Comp.
☒ Dry ☐ Other (Core, Water Supply etc.)

If OWWO: old well info as follows:

Operator
Well Name
Comp. Date Old Total Depth

WELL HISTORY

Drilling Method: ☒ Mud Rotary ☐ Air Rotary ☐ Cable

Jan 5, 1985 Jan 9, 1985 Jan 9, 1985

Spud Date Date Reached TD Completion Date

1975'

Total Depth PBTD

Amount of Surface Pipe Set and Cemented at 40 feet

Multiple Stage Cementing Collar Used? ☐ Yes ☒ No

If Yes, Show Depth Set feet

If alternate 2 completion, cement circulated
from 40' feet depth to 0' w/ 23 SX cmt

API NO. 15 - 045-20,761

County Douglas

NW-SE-NE Sec 27 Twp 14 Rge 20E West

3630 Ft North from Southeast Corner of Section
990 Ft West from Southeast Corner of Section
(Note: locate well in section plat below)


Lease Name Yukon Well# 27-1

Field Name Wildcat

Producing Formation None

Elevation: Ground 1150 KB 1156

Section Plat

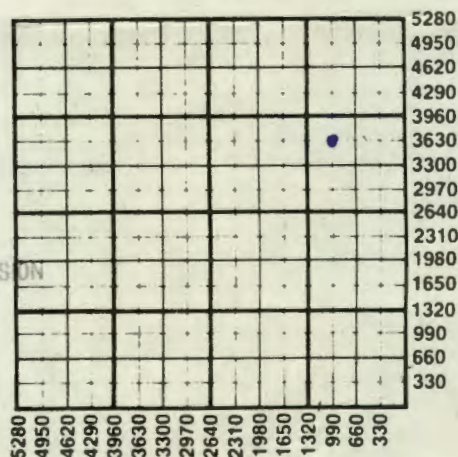

RECEIVED
STATE CORPORATION COMMISSION
FEB 14 1985
CONSERVATION DIVISION
Wichita, Kansas

WATER SUPPLY INFORMATION

Source of Water:

Division of Water Resources Permit #

☐ Groundwater Ft North From Southeast Corner and
(Well) Ft West From Southeast Corner of
Sec Twp Rge East West

☐ Surface Water Ft North From Southeast Corner and
(Stream, Pond etc.) Ft West From Southeast Corner
Sec Twp Rge East West

☐ Other (explain) Municipal (Baldwin City)
(purchased from city, R.W.D.#)

Disposition of Produced Water: ☐ Disposal ☐ Repressuring

Docket #

INSTRUCTIONS: This form shall be completed in duplicate and filed with the Kansas Corporation Commission, 200 Colorado Derby Building, Wichita, Kansas 67202, within 90 days after completion or recompletion of any well. Rules 82-3-130 and 82-3-107 apply.

Information on side two of this form will be held confidential for a period of 12 months if requested in writing and submitted with the form. See rule 82-3-107 for confidentiality in excess of 12 months.

One copy of all wireline logs and drillers time log shall be attached with this form. Submit CP-4 form with all plugged wells. Submit CP-111 form with all temporarily abandoned wells.

All requirements of the statutes, rules, and regulations promulgated to regulate the oil and gas industry have been fully complied with and the statements herein are complete and correct to the best of my knowledge.

SIDE TWO

Operator Name Maple Leaf Energy Corp. Lease Name Yukon Well# 27- SEC. 27... TWP. 14... RGE. 20 E... ☐ East ☐ West

WELL LOG

INSTRUCTIONS: Show important tops and base of formations penetrated. Detail all cores. Report all drill stem giving interval tested, time tool open and closed, flowing and shut-in pressures, whether shut-in pressure reached static level, hydrostatic pressures, bottom hole temperature, fluid recovery, and flow rates if gas to surface during test. Attach extra sheet if more space is needed. Attach copy of log.

Drill Stem Tests Taken
Samples Sent to Geological Survey
Cores Taken

☐ Yes ☒ No
☒ Yes ☐ No
☐ Yes ☒ No

Formation Description
☒ Log ☐ Sample

Name	Top	Bottom
Lansing	298	414
Kansas City	414	670
Pleasanton	670	800
Marmaton	800	922
Cherokee	922	1384
Mississippian	1384	1698
Kinderhook	1698	1758
Viola	1758	1860
Simpson	1860	1920
Simpson Sd.	1894	1920
Arbuckle Dolomite	1920	TD

CASING RECORD

☐ new ☒ used

Report all strings set - conductor, surface, intermediate, production, etc.

Purpose of string	size hole drilled	size casing set (in O.D.)	weight lbs/ft.	setting depth	type of cement	# sacks used	type and percent additives
Surface	12 1/4"	8 5/8"		40	Common	23	2% CaCl

PERFORATION RECORD

shots per foot

specify footage of each interval perforated

Acid, Fracture, Shot, Cement Squeeze Record

(amount and kind of material used)

Depth

NONE	NONE	