

This form shall be filed in duplicate with the Kansas Corporation Commission, 200 Colorado Derby Building, Wichita, Kansas 67202, within ten days after the completion of the well, regardless of how the well was completed.

Attach separate letter of request if the information is to be held confidential. If confidential, only file one copy. Information on side one will be of public record and side two will then be held confidential.

Circle one: Oil, Gas, Dry, SWD, OWWO, Injection. Type and complete ALL sections. Applications must be filed for dual completion, commingling, SWD and injection, T.A.

Attach wireline logs (i.e. electrical log, sonic log, gamma ray neutron log, etc.). KCC # (316) 263-3238. (Rules 82-2-105 & 82-2-125)

OPERATOR Bride Production Company

API NO. 15-045-20,307

ADDRESS Box 7470

COUNTY Douglas

Shawnee Mission, Kansas 66207

FIELD _____

**CONTACT PERSON Kent Fry

PROD. FORMATION _____

PHONE 913-749-3516

LEASE Lawrence

PURCHASER none

WELL NO. 1-82

ADDRESS _____

WELL LOCATION _____

DRILLING C & R Drilling, Inc.

330 Ft. from South Line and

CONTRACTOR _____

330 Ft. from West Line of


ADDRESS 8080 Ward Parkway Suite 440

the NW SEC. 19 TWP. 14s RGE. 20e

Kansas City, Missouri 64114

WELL PLAT

PLUGGING C & R Drilling Inc.

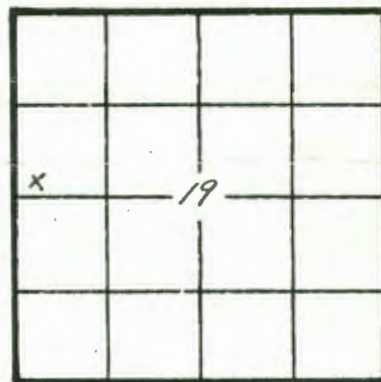

CONTRACTOR _____

KCC _____
KGS _____
(Office Use)

ADDRESS same as above

TOTAL DEPTH 996 PBD _____

SPUD DATE 3/24/82 DATE COMPLETED 3/29/82

ELEV: GR 1087 DF _____ KB _____

DRILLED WITH (CABLE) (ROTARY) (AIR) TOOLS

Amount of surface pipe set and cemented 60' DV Tool Used? no

AFFIDAVIT

STATE OF Kansas, COUNTY OF Douglas SS, I, _____

E. Kent Fry OF LAWFUL AGE, BEING FIRST DULY SWORN UPON HIS OATH,

DEPOSES THAT HE IS an employee (~~FOR~~)(OF) Bride Production Company

OPERATOR OF THE Lawrence LEASE, AND IS DULY AUTHORIZED TO MAKE

THIS AFFIDAVIT FOR AND ON THE BEHALF OF SAID OPERATOR, THAT WELL NO. 1-82 ON

SAID LEASE HAS BEEN COMPLETED AS OF THE 29th DAY OF March, 19 82

ALL INFORMATION ENTERED HEREIN WITH RESPECT TO SAID WELL IS TRUE AND CORRECT.

FURTHER AFFIANT SAITH NOT.

(S) [Signature]

RECEIVED
KANSAS CORPORATION COMMISSION
APR - 5 1982

SUBSCRIBED AND SWORN BEFORE ME THIS 30th DAY OF March, 19 82

LINDA WATRAN
NOTARY PUBLIC
LEAVENWORTH COUNTY, KANSAS

[Signature]

My Appointment Expires _____
MY COMMISSION EXPIRES: May 19, 1982

NOTARY PUBLIC

**The person who can be reached by phone regarding any questions concerning this information. Within 45 days of completion, a witnessed initial test by the Commission is required if the well produces more than 25 BOPD or is located in a Basic Order Pool.

IDE TWO

WELL LOG

SHOW GEOLOGICAL MARKERS, LOGS RUN, OR OTHER DESCRIPTIVE INFORMATION.

Show all important zones of porosity and contents thereof; cored intervals, and all drill-stem tests, including depth interval tested, cushion used, time tool open, flowing and shut-in pressures, and recoveries.

FORMATION DESCRIPTION; CONTENTS, ETC.	TOP	BOTTOM	NAME	DEPTH
Bartlesville Sand	978	986		19-14 0 -20e
core - dry sand	980	996		
DRY HOLE				

Report of all strings set — surface, intermediate, production, etc. CASING RECORD (New) or ~~(XXXX)~~

Purpose of string	Size hole drilled	Size casing set (in O.D.)	Weight lbs/ft.	Setting depth	Type cement	Socks	Type and percent additives
surface	9 1/4"	6"	10	60'	portland	4	

LINER RECORD

PERFORATION RECORD

Depth, ft.	Bottom, ft.	Socks cement	Shots per ft.	Size & type	Depth interval

TUBING RECORD

Setting depth	Pecker set at

ACID, FRACTURE, SHOT, CEMENT SQUEEZE RECORD

Amount and kind of material used	Depth interval treated

Date of first production	Producing method (flowing, pumping, gas lift, etc.)	Gravity
dry hole		
DATE OF PRODUCTION PER 24 HOURS	Oil bbls.	Gas MCF
	Water %	Gas-oil ratio CFPB
Disposition of gas (vented, used on lease or sold)		Perforations

528353

19-14-20e